

KANSAS Kansas Pool Name Hall-Gurney

KANSAS Kansas Pool Name Hall-Gurney

Map No. 55 Sec. 28 Twp. 15 R. 12W

Map No. 55 Sec. 28 Twp. 15 R. 12W

Well No. 3 Luerman

Well No. 3 Luerman

Harry Gore Company

Harry Gore Company

FIRST REPORT

COMPLETED

Contractor

Contractor

NE/c

SECTION PLAT

330 Ft. from N. Line

\_\_\_\_\_ Ft. from S. Line

330 Ft. from E. Line

\_\_\_\_\_ Ft. from W. Line

			0

Russell County

NE/C

SECTION PLAT

330 Ft. from N. Line

\_\_\_\_\_ Ft. from S. Line

330 Ft. from E. Line

\_\_\_\_\_ Ft. from W. Line

			0

Russell County

Location X

RECORD

Cased \_\_\_\_\_ in., \_\_\_\_\_ ft.

Sand \_\_\_\_\_

Gas \_\_\_\_\_

Oil \_\_\_\_\_

Total Depth \_\_\_\_\_

PRODUCTION

1st 24 hrs. Nat. \_\_\_\_\_

1st 24 hrs. after shot \_\_\_\_\_

Gas \_\_\_\_\_ Cu. Ft.

Dry Hole \_\_\_\_\_

Abandoned \_\_\_\_\_

Rig up \_\_\_\_\_

Drilling and Remarks:

Location \_\_\_\_\_

RECORD

Cased \_\_\_\_\_ in., \_\_\_\_\_ ft.

Sand \_\_\_\_\_

Gas \_\_\_\_\_

Oil \_\_\_\_\_

Total Depth 2794

PRODUCTION

1st 24 hrs. Nat. \_\_\_\_\_

1st 24 hrs. after shot \_\_\_\_\_

Gas \_\_\_\_\_ Cu. Ft.

Dry Hole \_\_\_\_\_

Abandoned \_\_\_\_\_

Rig up \_\_\_\_\_

Drilling and Remarks:

Yureka 2575

5" @ 2794

3000 acid

Pump 525 Pst

892 88

Date

Date

MAR 27 1946 19 S. J. LEWIS Scout

JUL 24 1946 19 S. J. LEWIS Scout

Sec. 28 Twp. 15 R. 12W

Well No. #3 Luerman Farm

Harry Gore Company


Hall-Gurney

330 Ft. from N. Line

\_\_\_\_\_ Ft. from S. Line

330 Ft. from E. Line

\_\_\_\_\_ Ft. from W. Line

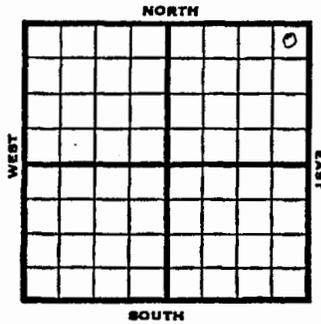

NE/c

1946

7/24 Topeka 2585  
7" @ 2785  
3000 acid.  
TD 2794  
Pump 825 Pot.  
Grav. 39.7

COMPLETED

1946	Elev. 1787	REPORT
3/27		Location
4/4		Drlg. 150'
4/10		SD
4/16		150" SD
4/23		" "
5/1		" "
5/7		" "
5/14		" "
5/21		" "
5.29		Drlg. 350'
6/5		12" @ 400 Drlg. 1422'
6/12		2145 Hr 8"
6/18		2415 Hr 8"
6/26		8" @ 2396' Topeka 2585 7" @ 2779 SD
7/3		TD 2792 7" @ 2785 WOC
7/9		TD2794 3000 acid Flow 50 oil PH
7/16		Flow 164 oil in 2 hrs
OVER		

O.W.D.D

S-513-B

County Russell Elev. 1787  
 Sec. 28 Twp. 15 Rge. 12W  
 Company Ted Gore (was Harry Gore)  
 Farm Name Luernan No. 3

TOPS	DEPTH	LOG	DATUM
Anh.			
Tp.	2730		
H.	2812		
Tr.			
Dg.			
B.L.			
L.	2929		
K.C.			
B.K.C.			
Ce.			
C.			
M.			
M.			
K.			
Mz.			
Mq.			
V.			
S.			
S.			
A.			
R.			
Pf.			
G.			
T.D.			

Loc. in Sec. NE NE NE  
OWDD  
 Geol. \_\_\_\_\_  
 Contr. K & EDrlg.  
 Pool Hall-Gurney

**FIRST REPORT**  
 JUN 25 58

Date Comm. drlg. 3055

Co. Sec. T. R.

O.W.D.D

S-513-B

County Russell Elev. 1787  
 Sec. 28 Twp. 15 Rge. 12W  
 Company Ted Gore (was Harry Gore)  
 Farm Name Luernan No. 3

TOPS	DEPTH	LOG	DATUM
Anh.			
Tp.	2730		
H.	2812		
Tr.			
Dg.	2873		
B.L.			
L.	2929		
K.C.			
B.K.C.			
Ce.			
C.	A	3222	
M.			
M.			
K.			
Mz.			
Mq.			
V.			
S.			
S.			
A.			
R.			
Pf.			
G.			
O.T.D.	2794		

Loc. in Sec. NE NE NE  
OWDD  
 Geol. \_\_\_\_\_  
 Contr. K & EDrlg.  
 Pool Hall-Gurney

**ABANDONED**  
 JUL 2 58

Date Comm. drlg. 3055 JUL 2 58 DST 3060-85  
op 35' 20' M FPO-0 BHP 30/30  
DST 3030-85 60" 15' CO  
240' MSW FPO-0 BHP 800/30"  
DST 3200-50 60" 165 S0CM  
SW 590011 FPO-110 BHP 110/30"  
RTD 3250 no log

*D&H*

Co. Sec. T. R.

O. W. D. D.

FORM 51 5M 11-44 PETROL

KANSAS

Russell county

Section 28 Township 15 Range 12W

Well No. #3, Luerman

Company Harry Gore *Ted Gore*

