

Pool Name Forrest Hill

Map No. 55 Sec. 28 Twp. 15 R. 12W

Well No. 1 Luceman

Harry Gore Company

FIRST REPORT

C N L SW NE

SECTION PLAT

		o	

_____ Ft. from N. Line
990 Ft. from S. Line
 _____ Ft. from E. Line
660 Ft. from W. Line

Russell

Location X

Rig up _____

Drilling and Remarks: _____

RECORD

Cased _____ in., _____ ft.
 Sand _____
 Gas _____
 Oil _____
 Total Depth _____

PRODUCTION

1st 24 hrs. Nat. _____
 1st 24 hrs. after shot _____
 Gas _____ Cu. Ft.
 Dry Hole _____
 Abandoned _____

Date

DEC 20 1944 S. J. LEWIS Scout

Kansas Pool Name Forrest Hill

Map No. 55 Sec. 28 Twp. 15 R. 12W

Well No. 1 Luerman

Harry Gore Company

COMPLETED

Contractor

C N L SW NE

E11878
SECTION PLAT

		o	

_____ Ft. from N. Line
990 Ft. from S. Line
 _____ Ft. from E. Line
660 Ft. from W. Line

Russell County

Location _____

Rig up _____

Drilling and Remarks: _____

Type ka 2635
7" 0.2525"

3000 acio
Pump 697 P.S.

36292

RECORD

Cased _____ in., _____ ft.
 Sand _____
 Gas _____
 Oil _____
 Total Depth 2833

PRODUCTION

1st 24 hrs. Nat. _____
 1st 24 hrs. after shot _____
 Gas _____ Cu. Ft.
 Dry Hole _____
 Abandoned _____

Date

MAY 9 1945 S. J. LEWIS Scout

KANSAS

Russell

Sec. 28 Twp. 15 R. 12W

Well No. #1 Lucman Farm

Harry Gore Company


Horrest Hill

_____ Ft. from N. Line

990 Ft. from S. Line

_____ Ft. from E. Line

660 Ft. from W. Line

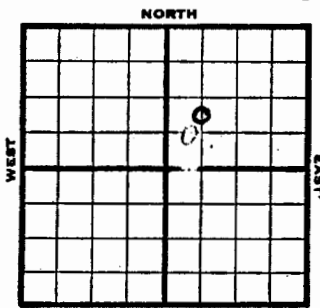

C N L SW NE Elev. 1818

REPORT

1944	Location
12/20	Location
12/29	"
<u>1945</u>	
1/3	"
1/10	"
1/17	"
1/26	"
1/31	"
2/7	"
2/14	"
2/21	"
2/28	"
3/7	"
3/14	447 Run 10"
3/23	12" @ 447 Anhy 708 10" @ 727 Drlg. 1480'
3/29	" " "
4/5	8" @ 2385 Drlg. 2630'
4/12	TD 2831 7" @ 2825' WOC

OVER

1945

4/20

Topeka 2635
TD 2833

2300' oil 24 hrs. 3000 acid.

4/27
5/9

Topeka 2635

7" @ 2825

TD 2833

3000 acid.

Pump 697 Pot.

Grav. 36.3

COMPLETED

Russell

KANSAS

FORM 51 5M BR1X

Section **28** Township **15** Range **12W**

Well No. **#1 Luceman**

Company **Harry Gore**

