

Russell

KANSAS ✓

Sec. 28 Twp. 15 R. 12W

Well No. #10 Klusner Farm

D.R. Lauck Oil Company

Lauck Contractor

Hall-Gurney Pool


330 Ft. from N. Line

_____ Ft. from S. Line

_____ Ft. from E. Line

1320 Ft. from W. Line

C N $\frac{1}{2}$ N $\frac{1}{2}$ SW

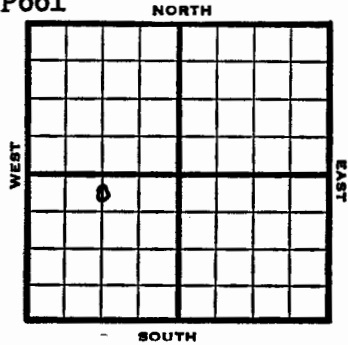


Russell

KANSAS

Section 28 Township 15 Range 12W

Well No. #10 Klusner

Company D.R. Lauck Oil

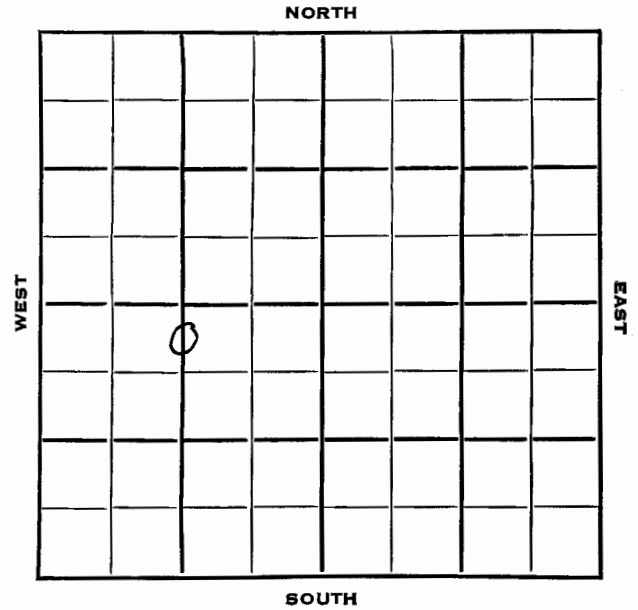

1953	Elev. 1848'	REPORT
4/29	Spud 4-25-53 8" @ 211' Anhy 770' Drlg 1000'	
5/7	Heeb 2929, Lans 3019, Arb 3296 RTD 3301 5" @ 3296'	
5/13	Spud 4-25-53 Oil Well TD 3301' 8" @ 211' Anhy 770, Heeb 2929, Lans 3019, Arb 3296 TD 3301' 5" @ 3296' CO yo 3301 FU 1000' oil 5 hr. S/ 48 bo S/ 7.8 boph Comp. 50 bopd.	
COMPLETED		