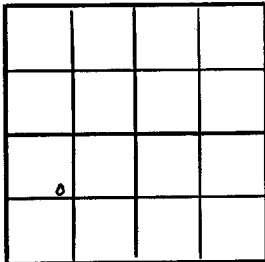


KANSAS Kansas Pool Name Forrest HillMap No. 55 Sec. 28 Twp. 15 R. 12WWell No. 6 KluesnerLocke & Moncrief etal CompanyFIRST REPORT Contractor
SE NW SW


SECTION PLAT

990 Ft. from N. Line Ft. from S. Line Ft. from E. Line990 Ft. from W. Line

Russell County

Location	X	RECORD
		Cased _____ in., _____ ft.
Rig up		Sand _____
Drilling and Remarks:		Gas _____
		Oil _____
		Total Depth _____
		PRODUCTION
		1st 24 hrs. Nat. _____
		1st 24 hrs. after shot _____
		Gas _____ Cu. Ft.
		Dry Hole _____
		Abandoned _____

Date

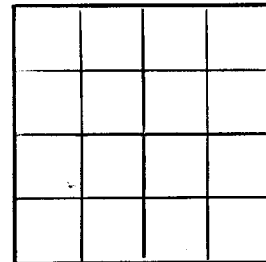AUG 8 1945 S. J. LEWIS ScoutKANSAS Kansas Pool Name Forrest HillMap No. 55 Sec. 28 Twp. 15 R. 12WWell No. 6 KluesnerLauck & Moncrief etal CompanyCOMPLETED Contractor
SE NW SWE 11842
SECTION PLAT990 Ft. from N. Line Ft. from S. Line Ft. from E. Line990 Ft. from W. Line

Russell County

Location	RECORD
	Cased _____ in., _____ ft.
Rig up	Sand _____
Drilling and Remarks:	Gas _____
	Oil _____
	Total Depth <u>8308</u>
	PRODUCTION
	1st 24 hrs. Nat. _____
	1st 24 hrs. after shot _____
	Gas _____ Cu. Ft.
	Dry Hole _____
	Abandoned _____

Date

OCT 17 1945 S. J. LEWIS Scout

KANSAS Russell

Sec. 28 Twp. 15 R. 12-W

Well No. #6 Kluesner Farm


Locke & Moncrief et al Company

990 Ft. from N. Line

Ft. from S. Line

Ft. from E. Line

990 Ft. from W. Line

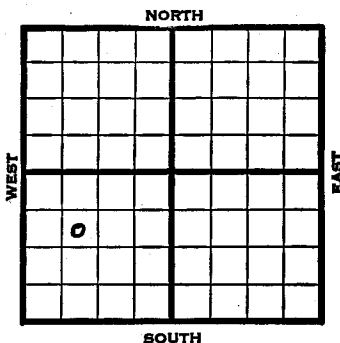

SE NW SW Elev. 1842

1945 REPORT

8/8 Location
8/15 Derrick
8/22 RUR
8/29 10" @ 192
Drlg. 224
9/5 Drlg. 2834
9/12 Lans 3012
Arb. 3294-3297
TD 3297
5" @ 3294 RUST
9/19 " " "
9/26 TD 3308'
Swab 15 oil per hr. 1 hr.
10/3 " " " "
10/10 " " " "
10/17 Arb. 3294
5" @ 3294
TD 3308'
Pump 194 Pot.
Grav. 38.0

COMPLETED

KANSAS Russell

Section 28 Township 15 Range 12W

Well No. 6 Kluesner

Company Locke & Moncrief et al

