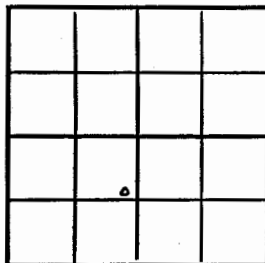


KANSAS Kansas Pool Name Forrest HillMap No. 55 Sec. 28 Twp. 15 R. 12WWell No. 5 KluesnerLocke & Moncrief et al CompanyFIRST REPORT Contractor

SE NE SW

SECTION PLAT

990 Ft. from N. Line Ft. from S. Line330 Ft. from E. Line Ft. from W. Line

Russell County

Location

RECORD

Cased in., ft.Sand Gas Oil Total Depth

PRODUCTION

1st 24 hrs. Nat. 1st 24 hrs. after shot Gas Cu. Ft.Dry Hole Abandoned

Date


AUG 8 1945

19

S. J. LEWIS ScoutKANSAS Kansas Pool Name Forrest HillMap No. 55 Sec. 28 Twp. 15 R. 12WWell No. 5 KluesnerLauck & Moncrief et al CompanyCOMPLETED Contractor

SE NE SW

SECTION PLAT

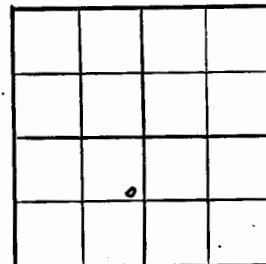990 Ft. from N. Line Ft. from S. Line330 Ft. from E. Line Ft. from W. Line

Russell County

Location

RECORD

Cased in., ft.Sand Gas Oil Total Depth 3258

PRODUCTION

1st 24 hrs. Nat. 1st 24 hrs. after shot Gas Cu. Ft.Dry Hole Abandoned

Date

OCT 3 1945

19

S. J. LEWIS

Scout

KANSAS

Russell

Sec. 28 Twp. 15 R. 12-W

Well No. #5 Kluesner Farm

Locke & Moncrief et al Company


990 Ft. from N. Line

 Ft. from S. Line

330 Ft. from E. Line

 Ft. from W. Line

SE NE SW Elev. 1811

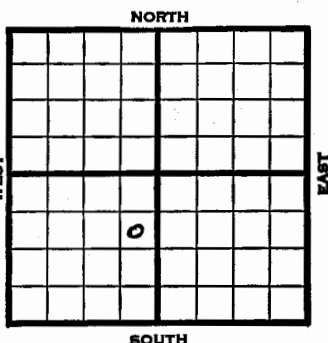

REPORT

1945

8/8

10" @ 200'

WOC

8/15

Drig. 2189

8/22

Lans 2971

Arb. 3246

TD 3256'

8/29

Arb. 3246

5" @ 3247

TD 3256'

1100' oil in 2 hrs.

9/5

TD 3259 swb. 25 oil per hr. 4 hrs.

9/12

" " " " " " "

9/19

" " " " " " "

9/26

" " " " " " "

10/3

Arb. 3246

5" @ 3247

TD 3259

Pump 351 Pot.

Grav. 39.0

COMPLETED

KANSAS

Russell

Section 28 Township 15 Range 12W

Well No. 5 Kluesner

Company Locke & Moncrief et al

