

KANSAS

Kansas Pool Name Forest HillMap No. 53 Sec. 28 Twp. 15 R. 12WWell No. 3 Klusener

Shell

FIRST REPORT

Company

Contractor

SW SE

SECTION PLAT

Ft. from N. Line

330 Ft. from S. Line

Ft. from E. Line

330 Ft. from W. Line

Russell County

		0	

Location

Rig up

Drilling and Remarks:

8"-734 WOC

RECORD

Cased in., ft.

Sand

Gas

Oil

Total Depth

PRODUCTION

1st 24 hrs. Nat.

1st 24 hrs. after shot

Gas Cu. Ft.

Dry Hole

Abandoned

Date

FEB 27 1946

19

S. J. LEWIS

Scout

KANSAS

Kansas Pool Name Forest HillMap No. 53 Sec. 28 Twp. 15 R. 12WWell No. 3 Klusener

Shell

Company

ABANDONED

Contractor

SW SE

SECTION PLAT

Ft. from N. Line

330 Ft. from S. Line

Ft. from E. Line

330 Ft. from W. Line

Russell County

		0	

Location

Rig up

Drilling and Remarks:

Art 3277

Lam 3302

4" 3278

Per Lam.

1000000

RECORD

Cased in., ft.

Sand

Gas

Oil

Total Depth 3272

PRODUCTION

1st 24 hrs. Nat.

1st 24 hrs. after shot

Gas Cu. Ft.

Dry Hole

Abandoned

Date

MAR 27 1946

19

S. J. LEWIS

Scout

KANSAS Russell County

Sec. 28 Twp. 15 R. 12W

Well No. #3 Klusener Farm

Shell Company

Forest Hill


Ft. from N. Line

330 Ft. from S. Line

Ft. from E. Line

330 Ft. from W. Line

SW SE

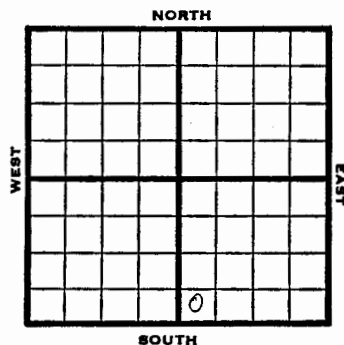

1946 Elev. 1824 REPORT

2/27 8" @ 734' WOC

3/7 Drlg. 2620'

3/14 Lans. 3002' Cong. 3268'
Arb. 3277-79' T.D. 4" - 3278'
RUST.

3/21 T.D. 3312' 1 bbls wtr per hr.

3/27 Arb. 3277
Lans 3002
4" @ 3278
Perf. Lans. 1000 acid.
TD 3312'

ABANDONED

KANSAS

Russell

Section 28 Township 15 Range 12-W

Well No. #3 Klusener

Company Shell

