

County Russell State Kansas  
 Sec. 29 (Blk. Twp.) 15 (Sur. Rge.) 12W Map No.  
 Operator Elreco  
 Well No. 4 Farm Steinle "B"  
 Elev. 1874 Location NW SW NE

		0		

990 Ft. From S Line NE  
330 Ft. From W Line Quarter  
 Ist. Report \_\_\_\_\_  
 Completion JUL 18 1951  
 Remarks Forest Hill Pool  
Sterling Drlg. - Contr.  
 Spudding Date 6-1-51

Drlg. Data Oil well TD 3307  
8" @ 313 Heeb. 2946 Br. lime 3035  
Lans. 3047 Arb. 3302 5" @ 3303 TD 3307  
S/ 44 boph Comp. draw down pot. 2232 bopd

J. E. TYRA

County Russell State Kansas  
 Sec. 29 (Blk. Twp.) 15 (Sur. Rge.) 12W Map No.  
 Operator Elreco  
 Well No. 4 Farm Steinle "B"  
 Elev. 1874 Location NW SW NE

		0		

990 Ft. From S Line NE  
330 Ft. From W Line Quarter  
 Ist. Report JUN 8 1951  
 Completion \_\_\_\_\_  
 Remarks \_\_\_\_\_  
Sterling Drlg. - Contr.  
 Spudding Date 6-1-51

Drlg. Data Forest Hill Pool  
8" @ 313 drlg. 2227

J. E. TYRA

Russell **KANSAS** ✓  
15 R. 12W

Sec. 29 Twp. \_\_\_\_\_ R. \_\_\_\_\_

Well No. #4 Steinle "B" Farm \_\_\_\_\_

Elreco Company \_\_\_\_\_

Sterling Drlg. - Contr. Contractor \_\_\_\_\_

Forest Hill Pool


\_\_\_\_\_ Ft. from N. Line

990' \_\_\_\_\_ Ft. from S. Line

\_\_\_\_\_ Ft. from E. Line

330' \_\_\_\_\_ Ft. from W. Line

NW SW NE

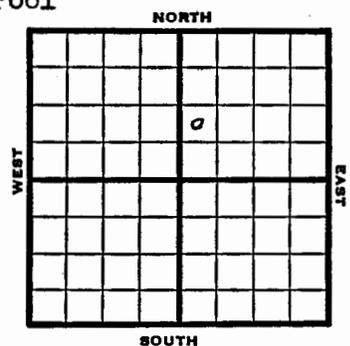


Russell **KANSAS**

Section 29 Township 15 Range 12W

Well No. #4 Steinle "B"

Company Elreco

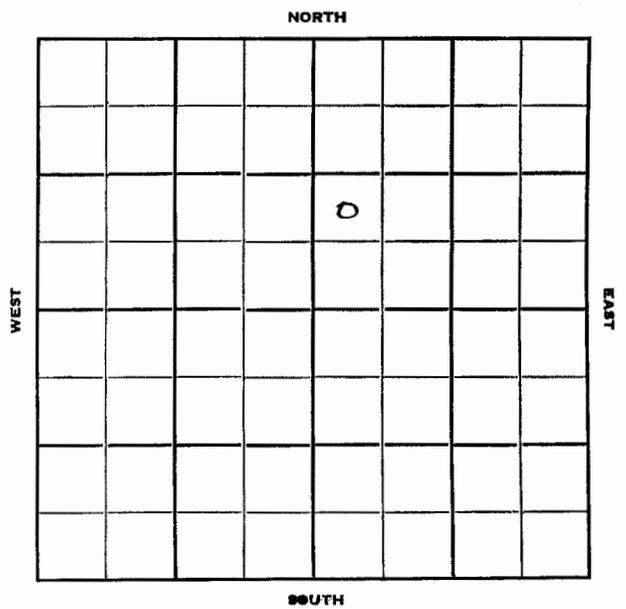

1951 "lev. 1874" REPORT

6/6 Spud 6-1-51  
8" @ 313  
Drlg. 2227'

7/18 Spud 6-1-51  
Oil well TD 3307' 8" @ 313  
Heeb 2946' Br. lime 3035' Lans,  
3047' Arb. 3302' 5" @ 3303  
TD 3307' S/44 BOPH  
Comp. draw down pot. 2232 BOPD

COMPLETED