

County	Russell	State	Kansas
Sec.	30	(Blk. Twp.)	15
		(Sur. Rge.)	12W
Operator	Elreco Ref.		
Well No.	6	Farm	Meier
Elev.	1864		
Location	C E $\frac{1}{2}$ NW SW		
	660 Ft. From N Line SW		
	990 Ft. From W Line Quarter		
1st. Report	MAR 2 1955		
Completion			
Remarks	Aylward - Contr.		
Spudding Date			

Drig. Data **Meier Pool**
M I R

FABEN GILSTRAP

County	Russell	State	Kansas
Sec.	30	(Blk. Twp.)	15
		(Sur. Rge.)	12W
Operator	Elreco Ref.		
Well No.	6	Farm	Meier
Elev.	1864		
Location	C E $\frac{1}{2}$ NW SW		
	660 Ft. From N Line SW		
	990 Ft. From W Line Quarter		
1st. Report	MAR 9 1955		
Completion			
Remarks	Meier Pool		
	Aylward - Contr.		
Spudding Date	3-1-55		

Drig. Data **D & A** **TD 3350**
8" @ 228 Anhy 809 Heeb. 2961
Br. lime 3044 Lens. 3056 Cong. 3326
Ch. Cong. 3336 Arb. 3348 TD 3350

D&A

FABEN GILSTRAP

Russell KANSAS

SEC. 30 TWP. 15 R. 12 W

WELL NO. # 6 Meier FARM

COMPANY Elreco Ref.

CONTRACTOR

Aylward
Meier Pool


660 Ft. from N. Line

Ft. from S. Line

Ft. from E. Line

990 Ft. from W. Line

C E $\frac{1}{2}$ NW SW

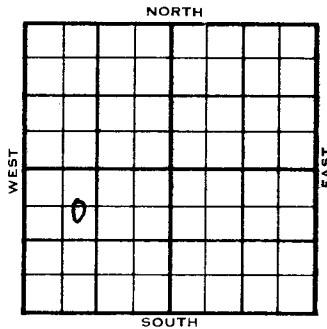

	ELEVATION	REPORT
1955	1864'	

3/2
3/9

MIR
Spud 3-1-55
D & A
TD 3350'
8" @ 228'
Anhy 809', Heeb 2961' Br. Lime 3044'
Lans 3056' Cong. 3326' Ch. Cong. 3336'
Arb. 3348'
TD 3350'
D & A

ABANDONED

DX 78-1

Russell KANSAS

Section 30 Township 15 Range 12W

Well No. 6 Meier

Company Elreco Ref.

