

Map No. _____ Sec. 30 Twp. 15 R. 12WWell No. 4 Meier

Eldorado Ref. etal. _____ Company

FIRST REPORT

Contractor _____

SE NE NW


SECTION PLAT

990 Ft. from N. Line

_____ Ft. from S. Line

330 Ft. from E. Line

_____ Ft. from W. Line

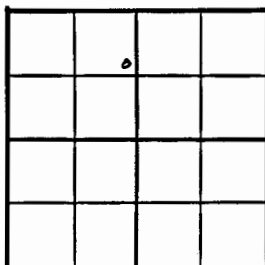

Russell County

Location _____

Rig up _____

Drilling and Remarks:

R U R

RECORD

Cased _____ in., _____ ft.

Sand _____

Gas _____

Oil _____

Total Depth _____

PRODUCTION

1st 24 hrs. Nat. _____

1st 24 hrs. after shot _____

Gas _____ Cu. Ft.

Dry Hole _____

Abandoned _____

Date

APR 13 1949

19

S. J. LEWIS

Scout

Map No. 455 Sec. 30 Twp. 15 R. 12WWell No. 4 Meier

Eldorado Ref. etal. _____ Company

ABANDONED

Contractor _____

SE NE NW


SECTION PLAT

990 Ft. from N. Line

_____ Ft. from S. Line

330 Ft. from E. Line

_____ Ft. from W. Line

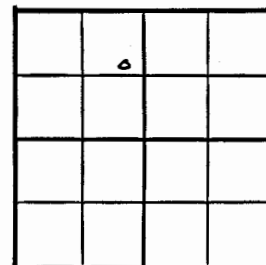

Russell County

Location _____

Rig up _____

Drilling and Remarks:

Long 331

RECORD

Cased _____ in., _____ ft.

Sand _____

Gas _____

Oil _____

Total Depth 332 in Dry

PRODUCTION

1st 24 hrs. Nat. _____

1st 24 hrs. after shot _____

Gas _____ Cu. Ft.

Dry Hole _____

Abandoned _____

Date

MAY 11 1949

19

S. J. LEWIS

Scout

KANSAS

Russell

Sec. 30 Twp. 15 R. 12W ✓

Well No. #4 Meir Farm

Eldorado Ref. et al Company

Meier Pool


990' Ft. from N. Line

_____ Ft. from S. Line

330' Ft. from E. Line

_____ Ft. from W. Line

SE NE NW

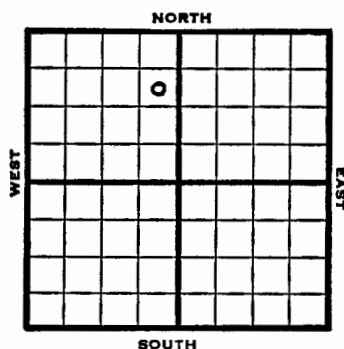

1949 Elev 1870' REPORT

4/13 RUR
4/20 Spud with a spudder
4/27 RUR
5/4 8" @ 150'
Lansing 3055'
Drlg 3212'
5/11 TD 3370 in Cong
Cong 3331'
Aband.

ABANDONED

KANSAS

Russell

Section 30 Township 15 Range 12W

Well No. 4 Meier

Company Eldorado Ref et al

Meier Pool

