Form 26 200 Bks. 9-48 Petrol Kansas

Ney Pool

Map No. ____ Sec. 30 Twp. 15 R. 12W

Well No. 2 Mier Meier

Eldorado Ref. etal. Company

FIRST REPORT Contractor

NW NE SW


SECTION PLAT

330 Ft. from N. Line

____ Ft. from S. Line

990 Ft. from E. Line

____ Ft. from W. Line

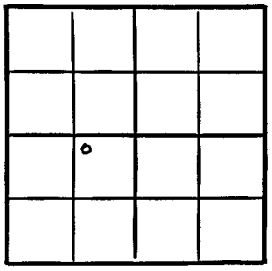

Russell County

Location X

Rig up ____

Drilling and Remarks:

RECORD

Cased ____ in., ____ ft.

Sand ____

Gas ____

Oil ____

Total Depth ____

PRODUCTION

1st 24 hrs. Nat. ____

1st 24 hrs. after shot ____

Gas ____ Cu. Ft.

Dry Hole ____

Abandoned ____

Date

OCT 13 1948 19 S. J. LEWIS Scout

Form 26 200 Bks. 9-48 Petrol Kansas

Ney Pool

Map No. 5 J Sec. 30 Twp. 15 R. 12W

Well No. 2 Meier

Eldorado Ref. etal. Company

COMPLETE Contractor

El. 1880

NW NE SW


SECTION PLAT

330 Ft. from N. Line

____ Ft. from S. Line

990 Ft. from E. Line

____ Ft. from W. Line

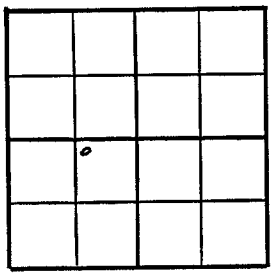

Russell County

Location ____

Rig up ____

Drilling and Remarks:

Ck 3333

5" Csg 3333

Pump 234 bbl

Pot

40 Sx Gel

RECORD

Cased ____ in., ____ ft.

Sand ____

Gas ____

Oil ✓

Total Depth 3338½

PRODUCTION

1st 24 hrs. Nat. ____

1st 24 hrs. after shot ____

Gas ____ Cu. Ft.

Dry Hole ____

Abandoned ____

Date

DEC 22 1948 19 S. J. LEWIS Scout

FORM 252-A
5M 10-48 PETROL

KANSAS Russell ✓

Sec. 30 Twp. 15 R. 12-W

Well No. #2 Mier Meier Farm

Eldorado Ref. etal Company

Ney Pool


330 Ft. from N. Line

Ft. from S. Line

990 Ft. from E. Line

Ft. from W. Line

NW NE SW

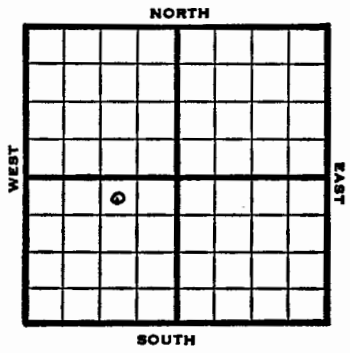

1948	Elev. 1880' REPORT
10/13	Location
10/19	"
10/26	W
11/3	8" @ 155' Drlg. 700'
11/10	Lansing 3069' Drlg. 3211'
11/16	Arbuckle 3333' 5" @ 3303' TD 3338½ 2900' oil, 12 hrs.
11/23	Swb 34 bbls oil 3 hrs.
11/30	"
12/8	"
12/15	"
12/22	Arb 3333' 5" @ 3333' Pump 234 oil Pot. Gr. 40.5° TD 3338½' COMPLETED

KANSAS Russell

FORM 51 10M 7-48 PETROL

Section 30 Township 15 Range 12W

Well No. #2 Mier Meier

Company Eldorado Ref. et al
Ney

