

Ney Pool

Map No. _____ Sec. 30 Twp. 15 R. 12W

Well No. 1 Meier


Eldorado Ref. _____ Company

FIRST REPORT

Contractor

SE NW

SECTION PLAT

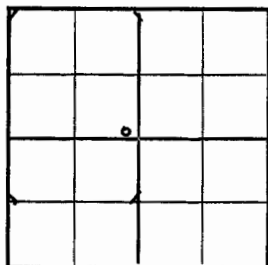

_____ Ft. from N. Line

330 _____ Ft. from S. Line

330 _____ Ft. from E. Line

_____ Ft. from W. Line

Russell County

Location _____

Rig up _____

Drilling and Remarks:

8" @ 338

Anhy 816

drlg. 2816

RECORD

Cased _____ in., _____ ft.

Sand _____

Gas _____

Oil _____

Total Depth _____

PRODUCTION

1st 24 hrs. Nat. _____

1st 24 hrs. after shot _____

Gas _____ Cu. Ft.

Dry Hole _____

Abandoned _____

Date

JUN 30 1948 19 _____ S. J. LEWIS Scout

Russell County Kansas State

Map No. 55 Sec. 30 Twp. 15 R. 12W

Well No. 1 Meier


Eldorado Ref. _____ Company

COMPLETE

Contractor

SE NW

SECTION PLAT

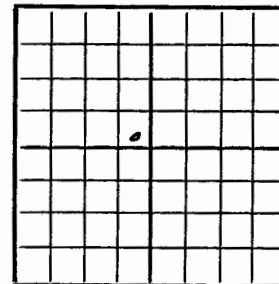

_____ Ft. from N. Line

330 _____ Ft. from S. Line

330 _____ Ft. from E. Line

_____ Ft. from W. Line

Ney Pool

Remarks:

Cased 3325

5" @ 3325

753337

Pump 252 oil Prod
4034Date
AUG 11 1948Scout
S. J. LEWIS

Russell



Sec. 30 Twp. 15 R. 12W

Well No. #1 Meier Farm

Eldorado Ref.

Company

Ney Pool


Ft. from N. Line

330' Fr. from S. Line

330' Fr. from E. Line

Ft. from W. Line

SE NW

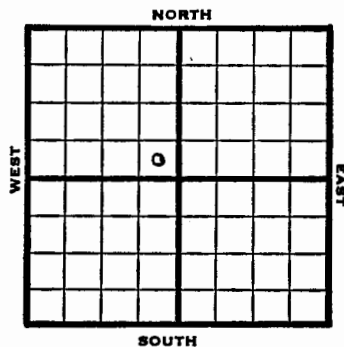

1948 Elev. 1871' REPORT

6/30 8" @ 338'
Ankry. 816'
Drlg. 2816'
7/8 Lansing 3050'
Arbuckle 3325'
TD 3327'
SO
5" @ 3325'
7/14 TD 3331'
swb 200 bbls oil 24 hrs.
7/21 Swb 12 bbls oil PH
7/28 "
8/4 "
8/11 Arbuckle 3325'
5" @ 3325'
TD 3337'
Pump 252 oil Pot.
Gr. 40.90

COMPLETED

KANSAS

Russell

Section 30 Township 15 Range 12-W

Well No. #1 Meier

Company Eldorado Ref.

