FORM 26 200 BKS 1-44 PETROL

KANSAS Pool Name Wildcat

Map No. 55 Sec. 30 Twp. 15 R. 12 W


Well No. 1 K Meir

Phil-Han[illegible] Company

FIRST REPORT Contractor

NW/C

SECTION PLAT

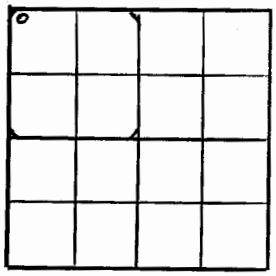

330 Ft. from N. Line

Ft. from S. Line

Ft. from E. Line

330 Ft. from W. Line

Russell County

Location

Rig up

Drilling and Remarks:

Surface Hole

RECORD

Cased in., ft.

Sand

Gas

Oil

Total Depth

PRODUCTION

1st 24 hrs. Nat.

1st 24 hrs. after shot

Gas Cu. Ft.

Dry Hole

Abandoned

Date

SEP 6 1944 19 S. J. LEWIS Scout

FORM 26 200 BKS 1-44 PETROL

Pool Name Wildcat

Map No. 55 Sec. 30 Twp. 15 R. 12W


Well No. 1 K. Meir

Phil-Han[illegible] Company

ABANDONED Contractor

NW/C

SECTION PLAT

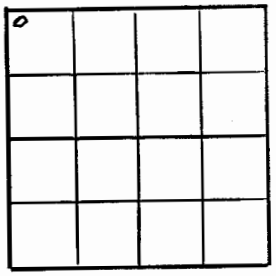

330 Ft. from N. Line

Ft. from S. Line

Ft. from E. Line

330 Ft. from W. Line

Russell County

Location

Rig up

Drilling and Remarks:

Ca T. 3385

RECORD

Cased in., ft.

Sand

Gas

Oil

Total Depth 3404

PRODUCTION

1st 24 hrs. Nat.

1st 24 hrs. after shot

Gas Cu. Ft.

Dry Hole

Abandoned

Date

SEP 20 1944 19 S. J. LEWIS Scout

FORM 252-A
5M 3-44 PETROL

KANSAS

Russell

Sec. 30 Twp. 15 R. 12W

Well No. #1 K Meir Farm

Phil-Han Company

Wildcat


330 Ft. from N. Line

_____ Ft. from S. Line

_____ Ft. from E. Line

330 Ft. from W. Line

NW/c

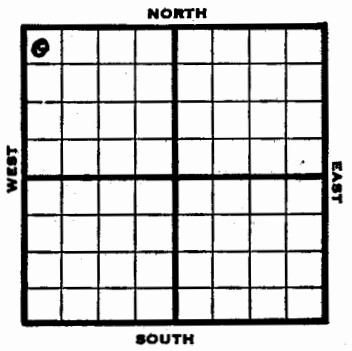

1944	REPORT
9/6	Surface hole
9/13	8" @ 400' Anhy 795' Drlg. 2812
9/20	Arb. 3368 TD 3404
	ABANDONED

KANSAS

FORM 51 5M BRIX

Russell County

Section 30 Township 15 Range 12W

Well No. #1 K. Meir

Company Phil-Han

