FORM 275 FOR SALE BY KANSAS BLUE PRINT CO.


County Russell State Kansas

Sec. 30 (Blk. Twp.) 15 (Sur. Rge.) 12W Map No.

Operator Wood River

Well No. 1 Farm Lang

Elev. Location SE SE SW

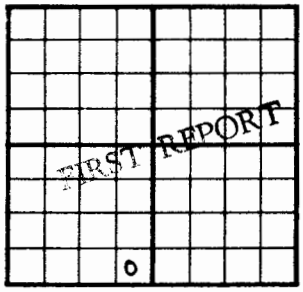

330 Ft. From S Line SW

330 Ft. From E Line Quarter

1st. Report FEB 21 1951

Completion

Remarks B & R Drlg. - Contr.

Spudding Date

Drlg. Data

Location

J. E. TYRA

FORM 275 FOR SALE BY KANSAS BLUE PRINT CO.


County Russell State Kansas

Sec. 30 (Blk. Twp.) 15 (Sur. Rge.) 12W Map No.

Operator Wood River

Well No. 1 Farm Lang

Elev. 1882 Location SE SE SW

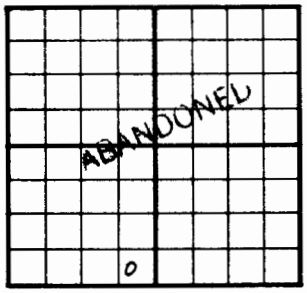

330 Ft. From S Line SW

330 Ft. From E Line Quarter

1st. Report

Completion MAR 7 1951

Remarks B & R Drlg. - Contr.

Spudding Date 2-21-51

Drlg. Data D & A TD 3362

8" @ 273 KC 3082 DST 3082-3107

open 1 hr. Rec. 11' socm DST 3243-55

open 1 hr. Rec. 17' socm Arb. 3355

DST 3356-59 open 1 hr. Rec. 10' oil

30' mud TD 3362 D & A

J. E. TYRA

Twp. ____ Pool ____

Co. ____ Facet ____

OWWO

S-513-B

County Russell Elev. 1880

Sec. 30 Twp. 15 Rge. 12W

Company Thunderbird (was Woodriver #1 Lang)

Farm Name Lang No. 3

TOPS	DEPTH	LOG	DATUM
Anh.			
Tp.			
H.			
Tr.			
Dg.			
B. L.			
L.			
K.C.	3082		
B.K.C.			
Ce.			
C.			
M.			
M.			
K.			
Mz.			
Mq.			
V.			
S.			
S.			
A.	3355	3358	
R.			
Pf.			
G.			
T.D.			

Loc. in Sec. SE SE SW

OWWO

Geol. ____

Contr. Co. tools

Pool Meier

FIRST REPORT FEB 19 '58

Date Comm. ____

OTD 3362 DD 3365 5" @ 3360/70 WOCT

Co. Lse. No. Sec. T. R.

6-513-B

County Russell Elev. 1880

Sec. 30 Twp. 15 Rge. 12W

Company Thunderbird (was Woodriver #1 Lang)

Farm Name Lang No. 3

TOPS	DEPTH	LOG	DATUM
Anh.			
Tp.			
H.			
Tr.			
Dg.			
B. L.			
L.			
K.C.	3082		
B.K.C.			
Ce.			
C.			
M.			
M.			
K.			
Mz.			
Mq.			
V.			
S.			
S.			
A.	3355	3359	
R.			
Pf.			
G.			
T.D.	3364		

Loc. in Sec. SE SE SW

OWWO

Geol. ____

Contr. Co. tools

Pool Meier

COMPLETE APR 9 '58

Date Comm. ____

OTD 3362 DD 3364 5" @ 3360/70 WOCT

MAR 26 '58 MAR 3 '58 to 3362 4 gaph

~~nat~~ nw 250A 15 gaph NW

70# A 2 Bopd NW 8 hrs DD

3364 TD pop MAR 12 '58 MAR 19 '58

MAR 26 '58 APR 3 '58 APR 9 '58 P 25 Bopd NW

25 Bopd + NW

Co. Lse. No. Sec. T. R.

FORM 252-B
10M 10-50 PETROL

Russell KANSAS

Sec. 30 Twp. 15 R. 12W

Well No. #1 Lang Farm

Wood River Company

B & R Drlg. - Contr. Contractor


____ Ft. from N. Line

330' Ft. from S. Line

330' Ft. from E. Line

____ Ft. from W. Line

SE SE SW

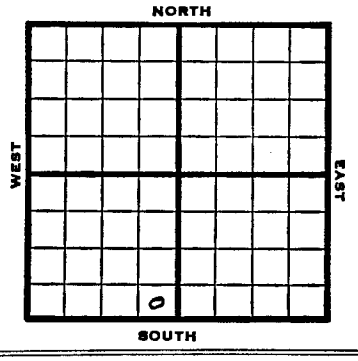

1951	Elev . 1882' REPORT
2/21	Location
3/7	Spud 2-21-51 D&A TD 3362 8"@ 273 KC 3082 DST 3082-3107 opn 1 hr Rec. 11' socm DST 3243-55 opn 1 hr Rec. 17' socm Arb. 3355 DST 3356-59 opn 1 hr Rec. 10' oil 30' mud TD 3362 D&A **ABANDONED**

O.W.W.O.
FORM 51 25M 8-50 WESTERN Russell KANSAS

Section 30 Township 15 Range 12 W

Well No. # 3 Lang

Company ~~Wood River~~ Thunderbird

