Form 26—1M Bks. 9-28

Russell


Map No. 55 Sec. 30 Twp. 15 R. 12W

Well No. 1- Dunn

Western Exploration Co Company

Contractor

SECTION PLAT

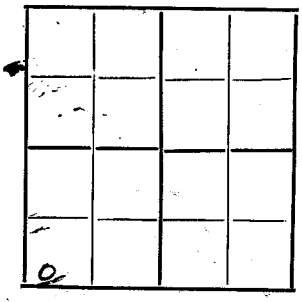

Ft. from N. Line

330 Ft. from S. Line

Ft. from E. Line

330 Ft. from W. Line

Location V

Rig up

Drilling and Remarks:

RECORD

Cased in., ft.

Sand

Gas

Oil

Total Depth

PRODUCTION

1st 24 hrs. Nat.

1st 24 hrs. after shot

Gas Cu. Ft.

Dry Hole

Abandoned

Date OCT 4 1939 O. Mannschreck Scout

Form 26—1M Bks. 9-28

Russell KANSAS

Map No. 55 Sec. 30 Twp. 15 R. 12W


Well No. 1- Dunn

Western Exp Co Company

Contractor

ABANDONED

SECTION PLAT

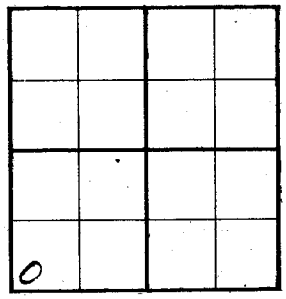

Ft. from N. Line

530 Ft. from S. Line

Ft. from E. Line

330 Ft. from W. Line

Location

Rig up

Drilling and Remarks:

D&A

RECORD

Cased in., ft.

Sand Miscons 3374

Gas

Oil

Total Depth 3387

PRODUCTION

1st 24 hrs. Nat.

1st 24 hrs. after shot

Gas Cu. Ft.

Dry Hole

Abandoned

Date 5-16-37 19

ORVAL MANNSCHRECK Scout


Russell

Form 252-A
5M 4-32 MPC

Map No. KANSAS Sec. 30 Twp. 15 R. 12W

Well No. 1 – Durr Farm

Western Exploration Company

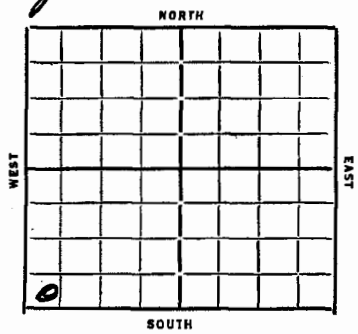

____ Ft. from N. Line

330 Ft. from S. Line

____ Ft. from E. Line

330 Ft. from W. Line

Date	REPORT 1874
1937	
10/4	loc
10/11	— 10/18 Spudding
10/25	Drlg 450
11/1	" 800
11/8	" 1120
11/15	" 1616
11/22	" 1895
11/29	" 1957
12/6	Fishing 1957
12/13	— 12/27 —
1/11	Skidded Rig
1/17	Drlg 335
1/24	" 850
1/31	—
2/7	Drlg 1175
2/14	" 1550
2/23	" 1560
3/1	" 1676
3/9	SD 1840
3/15	Drlg 2046
3/22	SD 2241
3/29	SD 2423

— OVER —

4/5 Drlg 2468
4/12 " 2603
4/19 " 2965
4/26 " 3280
5/3 Coring 3359
5/10 Silicone 3374 TD 3390
4" 3374 W.O.C.
5/16 Silicone 3374 TD 3387
D & A

ABANDONED


Russell

Form 51—5M—11-31—Palace

Map No. KANSAS Sec. 30 Twp. 15 R. 12W

Well No. 1 Neuro Farm

Western Exploration Co Company

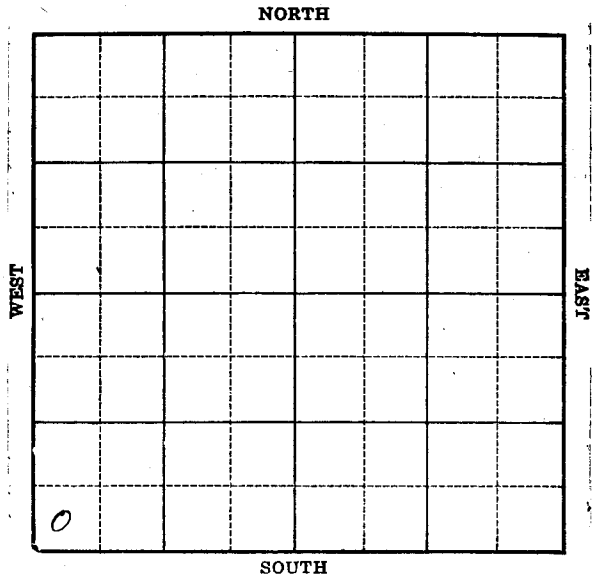

Location	Rig Up
Drilling Remarks	Drilling Remarks

RECORD

Cased ____ in. ____ ft.
Sand
Gas
Oil
Total Depth

PRODUCTION

1st 24 hrs. Nat.
1st 24 hrs. after shot
Gas ____ cu. ft.
Dry Hole
Abandoned