

Ney Pool

Map No. _____ Sec. 31 Twp. 15 R. 12W

Well No. 2 Durr

Woodriver Oil & Ref. Company

FIRST REPORT Contractor

SE NE SW

SECTION PLAT

| | | | |
|--|--|--|--|
| | | | |
| | | | |
| | | | |
| | | | |

990 Ft. from N. Line

_____ Ft. from S. Line

330 Ft. from E. Line

_____ Ft. from W. Line

Russell County

Location X

Rig up _____

Drilling and Remarks:

RECORD

Cased _____ in., _____ ft.

Sand _____

Gas _____

Oil _____

Total Depth _____

PRODUCTION

1st 24 hrs. Nat. _____

1st 24 hrs. after shot _____

Gas _____ Cu. Ft.

Dry Hole _____

Abandoned _____

Date

JUL 8 1948 19 S. J. LEWIS Scout

Russell County Kansas State

Map No. 55 Sec. 31 Twp. 15 R. 12W

Well No. 2 Durr

Woodriver Oil & Ref. Company

ABANDONED

Contractor

SE NE SW

SECTION PLAT

| | | | | | |
|--|--|--|--|--|--|
| | | | | | |
| | | | | | |
990 Ft. from N. Line

_____ Ft. from S. Line

330 Ft. from E. Line

_____ Ft. from W. Line

Ney Pool

Remarks:

Cur 3366
Rayon 3741
W 3453

Date
SEP 1 1948

Scout S. J. LEWIS

Sec. 31 Twp. 15 R. 12W ✓

Section 31 Township 15 Range 12W

Well No. #2 Durr Farm _____
Woodriver Oil & Ref. Company _____

Well No. #2 Durr

Company Woodriver Oil & Ref.

Ney Pool



990' Ft. from N. Line

_____ Ft. from S. Line

330' Ft. from E. Line

_____ Ft. from W. Line

SE NE SW

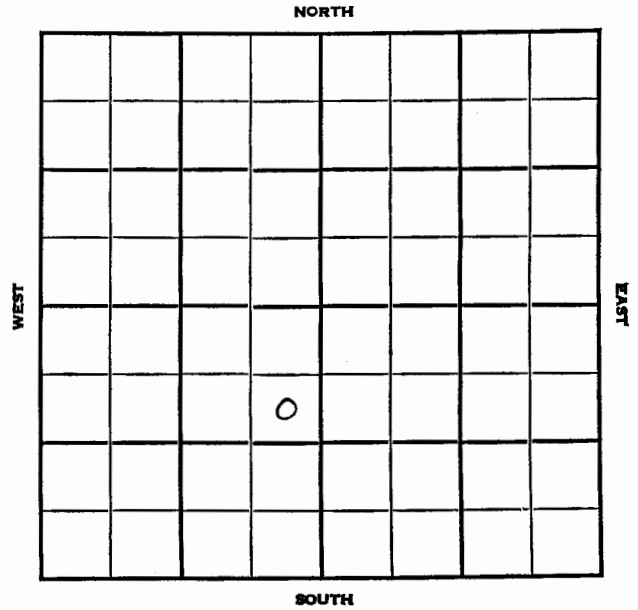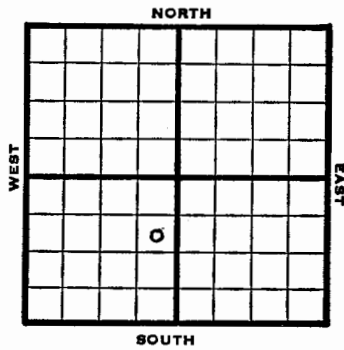

1948 Eli 1887' REPORT

| | |
|------|--|
| 7/8 | Location |
| 7/14 | " |
| 7/21 | " |
| 7/28 | " |
| 8/4 | " |
| 8/11 | 10" @ 206' |
| 8/18 | WOO Drlg 2983' |
| 8/25 | Lansing 3089' BKC 3333' Arbuckle 3366' TD 3390 |
| 9/1 | 7" @ 3386' Arb. 3366' Reagan 3441' TD 3453' Aband. |

ABANDONED