

County **Russell** State **Kansas**

Sec. **31** (Blk. Twp.) **15** (Sur. Rge.) **12W** Map No.

Operator **Peel-Hardman**

Well No. **1** Farm **Durr**

Elev. **1893** Location **SE SE NW (twinwell)**

FIRST REPORT

ABANDONED

330 Ft. From **S** Line **NW**

330 Ft. From **E** Line **Quarter**

1st. Report **FEB 3 1954**

Completion **FEB 3 1954**

Remarks **Peel-Hardman - Contr.**

Spudding Date **1-22-54**

Drig. Data **D & A TD 3375 Ney Pool**

Anhy 810 Top. 2724 KC 3099

Cong. 3363 DST 2938-3063 open 1/2 hr.

Rec. 20' mud 745# DST 3241-95

open 1 hr. Rec. 210' mud & wtr. 1000#

TD 3375

D & A

J. G. McGENEE

Russell KANSAS

SEC. **31** TWP. **15** R. **12 W** ✓

WELL NO. **# 1 Durr** FARM

COMPANY **Peel-Hardman**

CONTRACTOR **Peel-Hardman**

Ney Pool


Ft. from N. Line

330 Ft. from S. Line

330 Ft. from E. Line

Ft. from W. Line

SE SE NW (Twin)

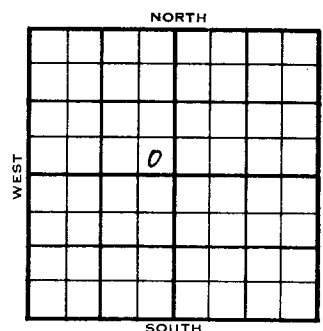

	ELEVATION	REPORT
1954	1893'	
2/3		Spud 1-22-54 D & A TD 3375' Anhy 810' Top. 2724' KC 3099' Cong. 3363' DST 2938-3063 open 1/2 hr, rec 20' mud 745# DST 3241-95 open 1 hr rec 210' mud & wtr. 1000# TD 3375' D & A

FIRST REPORT

ABANDONED

Section 31 Township 15 Range 12 WWell No. # 1 DurrCompany Pool-Hardman