Form 27—100 Bks.—4-48—Petrol

Russell County Kansas State

Map No. Sec. 32 Twp. 15 R. 12W


Well No. 1 Hilgenberg

Woodriver Oil & Ref. Company

FIRST REPORT Contractor

NW SW

SECTION PLAT

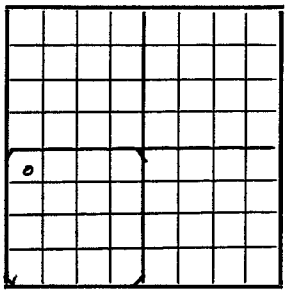

330 Ft. from N. Line

Ft. from S. Line

Ft. from E. Line

330 Ft. from W. Line

Ney Pool

Remarks:

Location

Date SEP 2 2 1948 Scout S. J. LEWIS

Form 26 200 Bks. 9-48 Petrol

Ney Pool

Kansas

Map No. 55 Sec. 32 Twp. 15 R. 12W

Well No. 1 Hilgenberg


Woodriver Oil & Ref. Company

COMPLETE Contractor

NW SW

E 1/2 SW

SECTION PLAT

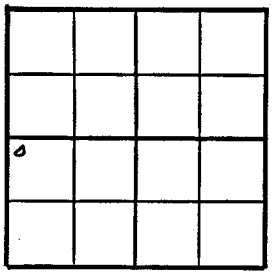

330 Ft. from N. Line

Ft. from S. Line

Ft. from E. Line

330 Ft. from W. Line

Russell County

Location

Rig up

Drilling and Remarks:

Anaydrite 3254

5" @ 3283.

Lans 3320

Perf Lans

Hoacid

Flow 1085 oil BO

SE SE

RECORD

Cased in., ft.

Sand

Gas

Oil ✓

Total Depth 3282

PRODUCTION

1st 24 hrs. Nat.

1st 24 hrs. after shot

Gas Cu. Ft.

Dry Hole

Abandoned

Date DEC 8 1948 19 S. J. LEWIS Scout

FORM 252-A
5M 4-48 PETROL

KANSAS Russell ✓

Sec. 32 Twp. 15 R. 12W

Well No. 1 Hilgenberg Farm

Woodriver Oil & Ref. Company

Ney Pool


330 Ft. from N. Line

Ft. from S. Line

Ft. from E. Line

330 Ft. from W. Line

NW SW

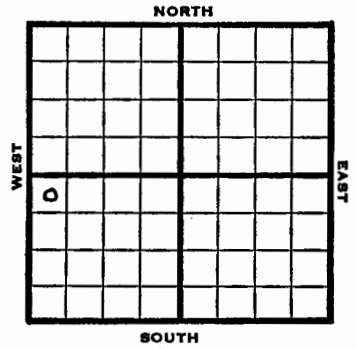

1948	Eli 1854' REPORT
9/22	Location
9/29	"
10/6	"
10/13	"
10/19	"
10/26	8"@ 217'
11/3	Drlg. 2865'
11/10	Lansing 3020' Quartzite 3284' TD 3292' 5" @ 3285'
11/16	85 shots 3044-56 1000 acid Flow 40 bbls oil PH
11/23	"
11/30	"
12/8	TD 3292' Quartzite 3284' 5"@ 3285' Lansing 3020' Perf Lans 1000 acid Flow 1035 Oil Pot 39° Gr. Comp COMPLETED

FORM 51 10M 7-48 PETROL

KANSAS Russell

Section 32 Township 15 Range 12W

Well No. 1 Hilgenberg

Company Woodriver Oil & Ref.

Ney Pool

