

Kansas

Map No. _____ Sec. 32 Twp. 15 R. 12W


Well No. 2 Hilgenberg

N C R A & Armer Company

Contractor

C S $\frac{1}{2}$ S $\frac{1}{2}$ SE

SECTION PLAT

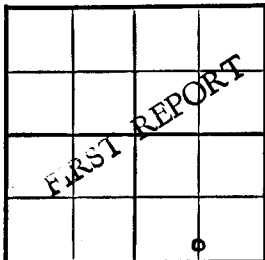

_____ Ft. from N. Line

330 Ft. from S. Line

1320 Ft. from E. Line

_____ Ft. from W. Line

Russell County

Location _____

Rig up _____

Drilling and Remarks:

Spud 2-13-50

8" @ 349 WOC

RECORD

Cased _____ in., _____ ft.

Sand _____

Gas _____

Oil _____

Total Depth _____

PRODUCTION

1st 24 hrs. Nat. _____

1st 24 hrs. after shot _____

Gas _____ Cu. Ft.

Dry Hole _____

Abandoned _____

Date

FEB 15 1950

19

J. E. TYRA

Scout

Map No. _____ Sec. 32 Twp. 15 R. 12W


Well No. 2 Hilgenberg

NCRA & Armer Drllg. Company

Contractor

C S $\frac{1}{2}$ S $\frac{1}{2}$ SE

SECTION PLAT

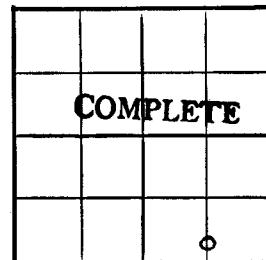

_____ Ft. from N. Line

330 Ft. from S. Line

1320 Ft. from E. Line

_____ Ft. from W. Line

Russell County

Location _____

Rig up _____

Drilling and Remarks:

8' @ 349

Kulr 2892

Br 2 2979

Sand 2990

5" @ 3256

Prof 15/3001-03

2/2994-97

P 48 BORD + 64 BWA PD

Date

APR 12 1950

19

J. E. TYRA

Scout

Russell KANSAS

Sec. 32 Twp. 15 R. 12W ✓

Well No. #2 Hilgenberg Farm

N C R A & Armer Company

Contractor


 Ft. from N. Line

330' Ft. from S. Line

1320' Ft. from E. Line

 Ft. from W. Line

C S $\frac{1}{2}$ S $\frac{1}{2}$ SE

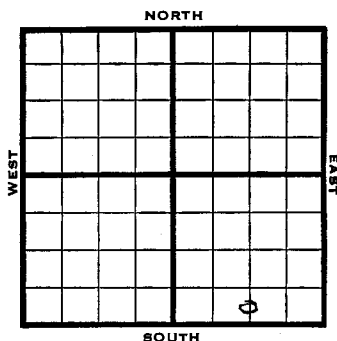

1950 REPORT

2/15 Spud 2-13-50
8" @ 349'
WOC
4/12 TD 3259'
8" @ 349'
Heeb 2892'
Br L 2979'
Lans 2990'
5" @ 3256'
Perf 15/3001-03
21/2994-97
48 BOPD / 64 Bwtr PD
Comp

COMPLETED

KANSAS Russell

Section 32 Township 15 Range 12-W

Well No. #2 Hilgenberg

Company N C R A & Armer

