


Russell County Kansas State
 Map No. _____ Sec. 32 Twp. 15 R. 12W
 Well No. 1 Hilgenberg
N C R A Company
FIRST REPORT Contractor
 SW SE

SECTION PLAT

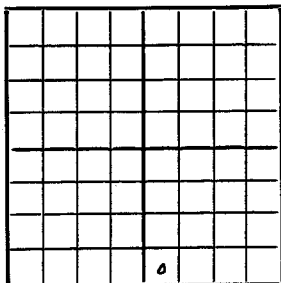

_____ Ft. from N. Line
330 Ft. from S. Line
 _____ Ft. from E. Line
330 Ft. from W. Line

Ney Pool
 Remarks:

Location


Date
 AUG 25 1948

Scout S. J. LEWIS

Ney Pool

Map No. 55 Sec. 32 Twp. 15 R. 12W
 Well No. 1 Hilgenberg
N C R A Company
ABANDONED Contractor
EL 1720
 SW SE

SECTION PLAT

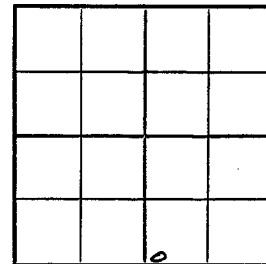

_____ Ft. from N. Line
330 Ft. from S. Line
 _____ Ft. from E. Line
330 Ft. from W. Line

Russell County

Location

Rig up

Drilling and Remarks:

*Quartzite 82%
 5' coarse
 Loma 3004
 Pry/Lane*

RECORD

Cased _____ in., _____ ft.
 Sand _____
 Gas _____
 Oil _____
 Total Depth 8291

PRODUCTION

1st 24 hrs. Nat. _____
 1st 24 hrs. after shot _____
 Gas _____ Cu. Ft.
 Dry Hole _____
 Abandoned _____

Date

SEP 29 1948

19

S. J. LEWIS

Scout

Sec. 32 Twp. 15 R. 12W

Well No. 1 Hilgenberg Farm

N C R A

Company

Ney Pool


Ft. from N. Line

330 Ft. from S. Line

Ft. from E. Line

330 Ft. from W. Line

SW SE

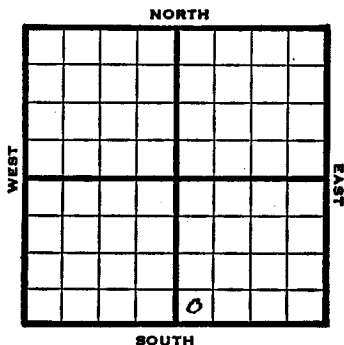

1948 Elev. 1830' REPORT

8/25 Location

9/1 8" @ 404'

WOC

9/8 Drlg 2155'

9/14 Lansing 3004'

Drlg 3100'

9/21 Quartzite 3291'

TD 3291'

5" @ 3285'

9/29 Quartzite 3291'

5" @ 3285'

Lans 3004'

Perf Lans.

TD 3291'

ABANDONED

Section 32 Township 15 Range 12W

Well No. 1 Hilgenberg

Company N C R A

New Pool
NORTH

