

Kansas

Map No. _____ Sec. 32 Twp. 15 R. 12W

Well No. 3 Hafeman Est.

Magnolia _____ Company

Barnett Drlg. _____ Contractor

NE SE SE

El. 1830
SECTION PLAT

_____ Ft. from N. Line

990 Ft. from S. Line

330 Ft. from E. Line

_____ Ft. from W. Line

Russell County

Location _____

RECORD

Cased _____ in., _____ ft.

Sand _____

Gas _____

Oil _____

Total Depth _____

PRODUCTION

1st 24 hrs. Nat. _____

1st 24 hrs. after shot _____

Gas _____ Cu. Ft.

Dry Hole _____

Abandoned _____

Drilling and Remarks:
Spud 2-9-50
9" @ 309
drlg. 1120

Date

FEB 15 1950 19 J. E. TYRA Scout

Kansas

Map No. _____ Sec. 32 Twp. 15 R. 12W

Well No. 3 Hafeman Est.

Magnolia _____ Company

Barnett Drlg. _____ Contractor

NE SE NE

El. 1830
SECTION PLAT

_____ Ft. from N. Line

990 Ft. from S. Line

330 Ft. from E. Line

_____ Ft. from W. Line

Russell County

Location _____

RECORD

Cased _____ in., _____ ft.

Sand _____

Gas _____

Oil _____

Total Depth _____

PRODUCTION

1st 24 hrs. Nat. _____

1st 24 hrs. after shot _____

Gas _____ Cu. Ft.

Dry Hole _____

Abandoned _____

Drilling and Remarks:

Reported
NE SE SE

Date

FEB 16 1950 19 J. E. TYRA Scout

Kansas

Forest Hill Pool

Russell
15

KANSAS ✓
12W

Sec. 32 Twp. 15 R. 12W

Map No. _____ Sec. 32 Twp. 15 R. 12W


Well No. 3 Hafeman Est.

Magnolia Company

Contractor

NE SE NE

SECTION PLAT

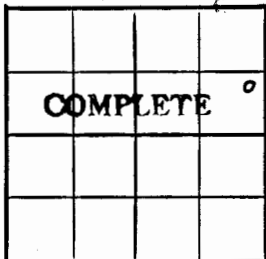

Ft. from N. Line

990 Ft. from S. Line

330 Ft. from E. Line

Ft. from W. Line

Russell County

Location _____

Rig up _____

Drilling and Remarks:

*9" @ 309
5" @ 3292
Lans 3005
Cong 3272
arb 3291
24 BOPD*

RECORD

Cased _____ in., _____ ft.

Sand _____

Gas _____

Oil _____

Total Depth *3299*

PRODUCTION

1st 24 hrs. Nat. _____

1st 24 hrs. after shot _____

Gas _____ Cu. Ft.

Dry Hole _____

Abandoned _____

Date

MAR 15 1950

19

J. E. TYRA

Scout

Well No. #3 Hafeman Est. Farm

Magnolia Company

Barnett Drlg. Contractor

Forest Hill Pool


Ft. from N. Line

990' Ft. from S. Line

330' Ft. from E. Line

Ft. from W. Line

NE SE ^{NF} SE

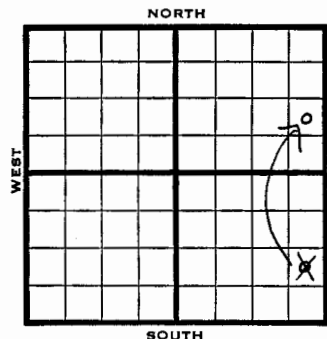

1950	Elev 1830'	REPORT
2/15	Spud 2-9-50 9" @ 309'	
	Drlg. 1120'	
3/15	TD 3299'	
	9" @ 309'	
	5" @ 3292'	
	Lans 3005'	
	Cong 3272'	
	Arb. 3291'	
	24 BOPD	
	Comp	

COMPLETED

Section 32 Township 15 Range 12-W

Well No. #3 Hafeman Est

Company Magnolia

