

Map No. 55 Sec. 33 Twp. 15 R. 12W
Well No. 2 Kaufman


W. L. Hartman Company

FIRST REPORT
and Contractor

NW SW SE

ABANDONED

SECTION PLAT

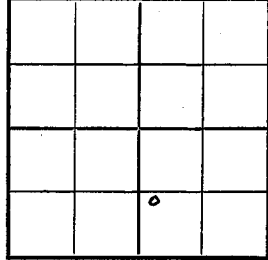

_____ Ft. from N. Line
990 Ft. from S. Line
_____ Ft. from E. Line
330 Ft. from W. Line

Russell County

Location _____

Rig up _____

Drilling and Remarks:

8" @ 200

Lans. 3050

Arb. 3341-83 TD

D & A

RECORD

Cased _____ in., _____ ft.

Sand _____

Gas _____

Oil _____

Total Depth 3383

PRODUCTION

1st 24 hrs. Nat. _____

1st 24 hrs. after shot _____

Gas _____ Cu. Ft.

Dry Hole _____

Abandoned _____

Date

APR 7 1948 19

S. J. LEWIS Scout



Sec. 33 Twp. 15 R. 12W

Well No. #2 Kaufman Farm _____

W. L. Hartman Company

Hall-Gurney


_____ Ft. from N. Line

990 Ft. from S. Line

_____ Ft. from E. Line

330 Ft. from W. Line

NW SW SE

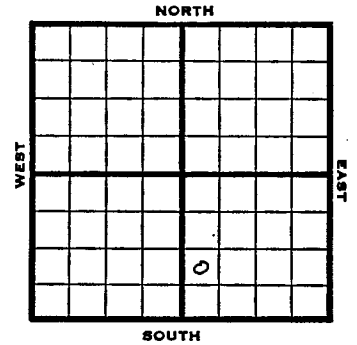

1948

REPORT

4/7

8" @ 200'

Lans. 3050'

Arb. 3341-83' TD

TD 3383'

D&A

FIRST REPORT

ABANDONED

Section 33 Township 15 Range 12-W

Well No. #2 Kaufman

Company W. L. Hartman

