Form 26 200 Bks. 11-49 Petrol

Kansas

Forest Hill

Map No. ____ Sec. 33 Twp. 15 R. 12W

Well No. 2 Grizzell

White Eagle Company

Murfin Drlg. Contractor

SW SW NW

El. 1811

SECTION PLAT



____ Ft. from N. Line

330 Ft. from S. Line

____ Ft. from E. Line

330 Ft. from W. Line

Russell County

Location ____

Rig up ____

Drilling and Remarks:

Spud 4-22-50

8" @ 460

drlg. 1625

RECORD

Cased ____ in., ____ ft.

Sand ____

Gas ____

Oil ____

Total Depth ____

PRODUCTION

1st 24 hrs. Nat. ____

1st 24 hrs. after shot ____

Gas ____ Cu. Ft.

Dry Hole ____

Abandoned ____

Date

MAY 3 1950 19

J. E. TYRA Scout

Form 26 200 Bks. 11-49 Petrol

Forest Hill Pool

Kansas

Map No. ____ Sec. 33 Twp. 15 R. 12W

Well No. 2 Grizzell


White Eagle Company

Contractor

SW SW NW

El. 1811

SECTION PLAT

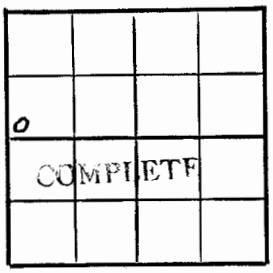

____ Ft. from N. Line

330 Ft. from S. Line

____ Ft. from E. Line

330 Ft. from W. Line

Russell

Location ____

Rig up ____

Drilling and Remarks:

8" @ 460

Lans. 2985

Heebner 2895

arb. 3262

SO 3266-68

5" @ 3262

swab 40 bo/hr

Comp. 680 Lloyd

RECORD

Cased ____ in., ____ ft.

Sand ____

Gas ____

Oil ____

Total Depth 3268

PRODUCTION

1st 24 hrs. Nat. ____

1st 24 hrs. after shot ____

Gas ____ Cu. Ft.

Dry Hole ____

Abandoned ____

Date

MAY 24 1950 19

J. E. TYRA Scout

FORM 252-B
10M 9-49 PETROL

Russell KANSAS

Sec. 33 Twp. 15 R. 12W

Well No. #2 Grizzell Farm

White Eagle Company

Murfin Drlg. Contractor

Forest Hill


____ Ft. from N. Line

330' Ft. from S. Line

____ Ft. from E. Line

330' Ft. from W. Line

SW SW NW

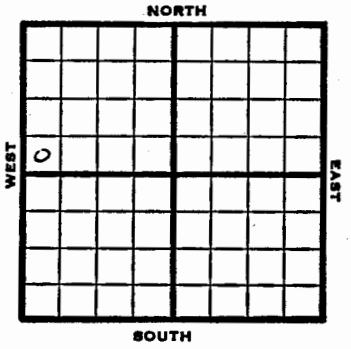

1950	Elev. 1811' REPORT
5/3	Spud 4-22-50 8" @ 460' Drlg. 1625'
5/24	8" @ 460' Lans. 2985' Heebner 2895' Arb. 3262' SO 3266-68 5" @ 3262' Swab 40 BOPH Comp. 680 BOPD TD 3268'

COMPLETED

FORM 51 25M 3-49 PETROL

Russell KANSAS

Section 33 Township 15 Range 12W

Well No. #2 Grizzell

Company White Eagle

