

KANSAS

Map No. 55 Sec. 33 Twp. 15 R. 12WWell No. 1 F. GrizzellHelmerich & Payne Company

FIRST REPORT

Contractor

NW SW NW


SECTION PLAT

Ft. from N. Line

990 Ft. from S. Line

Ft. from E. Line

330 Ft. from W. Line

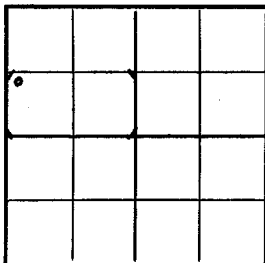

Forest Hill Pool

Location

Rig up

Drilling and Remarks:

10" - 290 WOC

RECORD

Cased in, ft.

Sand

Gas

Oil

Total Depth

PRODUCTION

1st 24 hrs. Nat.

1st 24 hrs. after shot

Gas Cu. Ft.

Dry Hole

Abandoned

Date

SEP 22 1943 19 S. J. LEWIS Scout

Russell

Map No. 55 Sec. 33 Twp. 15 R. 12WWell No. 1 F. GrizzellHelmerich & Payne Company

COMPLETED

Contractor

NW SW NW


SECTION PLAT

Ft. from N. Line

990 Ft. from S. Line

Ft. from E. Line

330 Ft. from W. Line

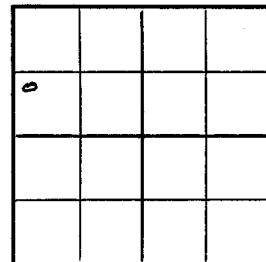

Forrest Hill Pool

Location

Rig up

Drilling and Remarks:

Cased 296

5" @ 3298

Pump 231 P.D.

33 2/3

RECORD

Cased in, ft.

Sand

Gas

Oil

Total Depth 3304

PRODUCTION

1st 24 hrs. Nat.

1st 24 hrs. after shot

Gas Cu. Ft.

Dry Hole


Abandoned

Date

OCT 20 1943 19 S. J. LEWIS Scout

KANSAS

Russell

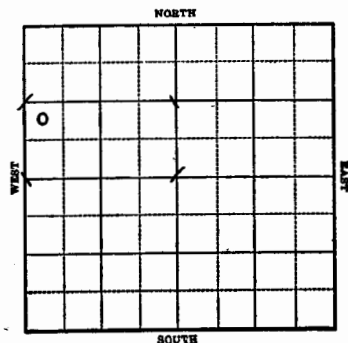Sec. 33 Twp. 15 R. 12-WWell No. #1 F. Grizzell FarmHelmerich & Payne Company

Ft. from N. Line

990 Ft. from S. Line

Ft. from E. Line

330 Ft. from W. Line

Elev. 1833

1943 REPORT

9/22 10" @ 290' WOC
9/29 Drlg. 2400'
10/6 Lins 3004
Cong. 3279
Arb 3296
5" @ 3298
T.D. 3302
rust
10/13 T.D. 3304
Swab 12 oil per hr $2\frac{1}{2}$ hrs.
10/20 Arb 3296
5" @ 3298
Pump 231 Pot.
T.D. 3304
Gravity 33.7

COMPLETED

KANSAS
FORM 51 5M PETROL

Russell

Section 33 Township 15 Range 12-WWell No. #1 F. GrizzellCompany Helmerich & Payne