

KANSAS⁵ Kansas Pool Name Hall-Gurney
 Map No. 56 Sec. 33 Twp. 15 R. 12W
 Well No. 1 Grizzell
Black-Marshall Company

FIRST REPORT Contractor

NW NE NW

SECTION PLAT

330 Ft. from N. Line

Ft. from S. Line

990 Ft. from E. Line

Ft. from W. Line

Russell County

Location

RECORD

Cased in, ft.

Sand

Gas

Oil

Total Depth

PRODUCTION

1st 24 hrs. Nat.

1st 24 hrs. after shot

Gas Cu. Ft.

Dry Hole

Abandoned

Date

MAY 8 1946 19 S. J. LEWIS Scout

KANSAS⁵ Kansas Pool Name Hall-Gurney Poq
 Map No. 56 Sec. 33 Twp. 15 R. 12W
 Well No. 1 Grizzell
Black-Marshall Company

ABANDONED

Contractor

NW NE NW

SECTION PLAT

330 Ft. from N. Line

Ft. from S. Line

990 Ft. from E. Line

Ft. from W. Line

Russell County

Location

RECORD

Cased in, ft.

Sand

Gas

Oil

Total Depth 2285

PRODUCTION

1st 24 hrs. Nat.

1st 24 hrs. after shot

Gas Cu. Ft.

Dry Hole

Abandoned

Date

MAY 2 9 1946 19 S. J. LEWIS Scout

KANSAS

Russell County

Sec. 33 Twp. 15 R. 12W

Well No. #1 Grizzell Farm

Black-Marshall Company

Hall-Gurney


330 Ft. from N. Line

Ft. from S. Line

990 Ft. from E. Line

Ft. from W. Line

NW NE NW

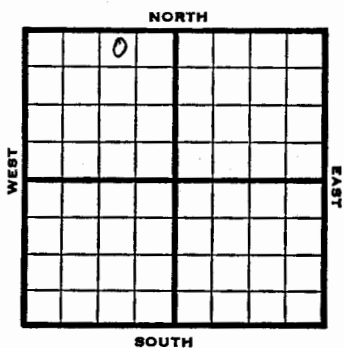

1946 Elev. 1804' REPORT

5/8 Location

5/14 8" @ 240 anhy 725
Drlg 1875'

5/21 Lans 2985-
Cong 3252-
3285 TD
5" @ 3280, RUST

5/29 Cong 3252'
5" @ 3280'
TD 3285'

ABANDONED

KANSAS Russell county

Section 33 Township 15 Range 12W

Well No. #1, Grizzell

Company Black-Marshall

