

Map No. _____ Sec. 34 Twp. 15 R. 12WWell No. 1 Hitchman

B & R Drlg. _____ Company

FIRST REPORT Contractor

SE NE SE

SECTION PLAT

990 Ft. from N. Line

_____ Ft. from S. Line

330 Ft. from E. Line

_____ Ft. from W. Line

Russell County

Location X

Rig up _____

Drilling and Remarks:

RECORD

Cased _____ in., _____ ft.

Sand _____

Gas _____

Oil _____

Total Depth _____

PRODUCTION

1st 24 hrs. Nat. _____

1st 24 hrs. after shot _____

Gas _____ Cu. Ft.

Dry Hole _____

Abandoned _____

Date

MAY 26 1948 19 S. J. LEWIS ScoutMap No. 55 Sec. 34 Twp. 15 R. 12WWell No. 1 Hitchman

B & R Drlg. _____ Company

COMPLETE Contractor

SE NE SE

SECTION PLAT

990 Ft. from N. Line

_____ Ft. from S. Line

330 Ft. from E. Line

_____ Ft. from W. Line

Russell County

Location _____

Rig up _____

Drilling and Remarks:

Ca 8347
5" @ 3345
500 acid
Pump 75 oil Pst

37 2/4

RECORD

Cased _____ in., _____ ft.

Sand _____

Gas _____

Oil ☒Total Depth 330

PRODUCTION

1st 24 hrs. Nat. _____

1st 24 hrs. after shot _____

Gas _____ Cu. Ft.

Dry Hole _____

Abandoned _____

Date

JUN 30 1948 19 S. J. LEWIS Scout

KANSAS

Russell

Sec. 34 Twp. 15 R. 12WWell No. #1 Hitchman Farm
B & R Drlg.

Forrest Hill Pool Company


990' Ft. from N. Line

Ft. from S. Line

330' Ft. from E. Line

Ft. from W. Line

SE NE SE

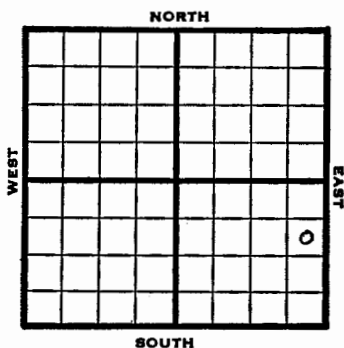

1948 Elev. 1895' REPORT

5/26 Location

6/1 8" @ 240'
Drlg. 2221'6/9 Lansing 3055
Arb. 3347-50
TD 3350'
SO
5" @ 3348'
RUST

6/16 500 Acid

6/23 TD 3356'
Pump 6 bbls oil PH6 30 Arbuckle 3347'
5" @ 3348'
500 Acid
Pump 75 oil Pot.
Gr. 37°
TD 3356'
COMPLETED

KANSAS

Russell

Section 34 Township 15 Range 12WWell No. #1 HitchmanCompany B&R Drlg.