

Dubuque Pool

Kansas

Map No. _____ Sec. 35 Twp. 15 R. 12WWell No. 2 Weber "A"Skelly Oil Company

Contractor

SW SW NW

SECTION PLAT



Ft. from N. Line

330 Ft. from S. Line

Ft. from E. Line

330 Ft. from W. Line

Russell County

Location

Rig up

Drilling and Remarks:

Spud 7-13-50

8" @ 760

Anhy 750

drlg. 2140

RECORD

Cased _____ in., _____ ft.

Sand _____

Gas _____

Oil _____

Total Depth _____

PRODUCTION

1st 24 hrs. Nat. _____

1st 24 hrs. after shot _____

Gas _____ Cu. Ft.

Dry Hole _____


Abandoned _____

Date

JUL 19 1950

19:

J. E. TYRA Scout

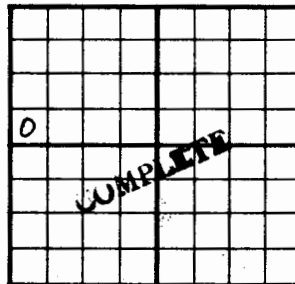County Russell State KansasSec. 35 (Blk. Twp.) 15 (Sur. Rge.) 12W Map No.Operator Skelly OilWell No. 2 Farm Weber "A"Elev. 1893 Location SW SW NW330 Ft. From S Line NW330 Ft. From W Line Quarter

1st. Report

Completion AUG 9 1950

Remarks

Spudding Date 7-13-50

Drlg. Data

Dubuque Pool

8" @ 760 Anhy 750 Heeb. 2964Leas. 3051 Cong. 3335 Arb. 33455" @ 3346 TD 3350 250 AComp. 336 bo 25 bwpd

J. E. TYRA

KANSAS Russell
Sec. 35 Twp. 15 R. 12-W ✓

Well No. #2 Weber "A" Farm
Skelly Oil Company
Contractor

Dubuque


Ft. from N. Line

330 Ft. from S. Line

Ft. from E. Line

330 Ft. from W. Line

SW SW NW

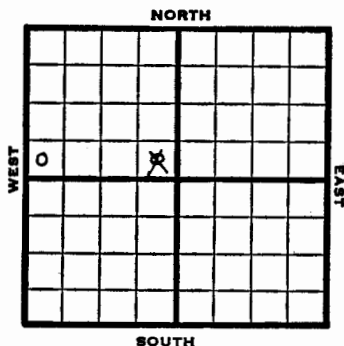

1950 Elev 1893 REPORT

7/19 Spud 7-13-50
8" @ 760
Anhy 750
drlg 2140

8/9 8" @ 760
Anhy 750 Heeb 2964
Lans 3051 Cong 3335
Arb 3345
5" @ 3346
TD 3350
250 A
Comp 336 bo 25 bwpd
Completed

COMPLETED

KANSAS Russell

Section 35 Township 15 Range 12-W
Well No. #2 Weber "A"
Company Skelly Oil

