

Pool Name WildcatMap No. 55 Sec. 36 Twp. 15 R. 12WWell No. 1 CaseyRaymond Gear etal CompanyFIRST REPORT Contractor

SE NW NE

SECTION PLAT

990 Ft. from N. Line Ft. from S. Line Ft. from E. Line990 Ft. from W. LineRussellLocation XRig up

Drilling and Remarks:

RECORD

Cased in., ft.Sand Gas Oil Total Depth

PRODUCTION

1st 24 hrs. Nat. 1st 24 hrs. after shot Gas Cu. Ft.Dry Hole Abandoned

Date

DEC 20 1944 19 S. J. LEWIS ScoutPool Name WildcatMap No. Sec. 36 Twp. 15 R. 12WWell No. 1 CaseyRaymond-Gear etal CompanyABANDONED Contractor

SE NW NE

SECTION PLAT

990 Ft. from N. Line Ft. from S. Line Ft. from E. Line990 Ft. from W. LineRussellLocation Rig up

Drilling and Remarks:

Oil 7383

RECORD

Cased in., ft.Sand Gas Oil Total Depth 3790

PRODUCTION

1st 24 hrs. Nat. 1st 24 hrs. after shot Gas Cu. Ft.Dry Hole Abandoned

Date


JAN 17 1945 19 S. J. LEWIS Scout

KANSAS

Russell

Sec. 36 Twp. 15 R. 12W

Well No. #1 Casey Farm
Raymond Gear etal Company
Wildcat

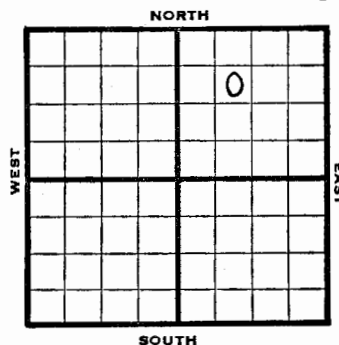

_____ 990. from N. Line

_____ Ft. from S. Line

_____ Ft. from E. Line

_____ 990. from W. Line

SE NW NE

1944 R E P O R T

12/20 Location

12/29 "

1945

1/3 Drlg 2293

1/10 Heebner 2930

Lens 3030 Stams 3125-51

B K C 3286 Cong 3321

Drlg 3326

1/17 Arb. 3383

TD 3400

ABANDONED

KANSAS

Russell

Section 36 Township 15 Range 12W

Well No. #1 Casey

Company Raymond Gear etal

