

Russell KANSAS

Map No. _____ Sec. 18 Twp. 15 R. 13W

Well No. 5 Meharg
Southern Company

Contractor

FIRST REPORT

SE NE NE

SECTION PLAT

990 Ft. from N. Line
_____ Ft. from S. Line
330 Ft. from E. Line
_____ Ft. from W. Line

CORALENA POOL

Location _____

RECORD

Cased _____ in., _____ ft.
Sand _____
Gas _____
Oil _____
Total Depth _____

Rig up _____

Drilling and Remarks:

ROTARY

PRODUCTION

1st 24 hrs. Nat. _____
1st 24 hrs. after shot _____
Gas _____ Cu. Ft.
Dry Hole _____
Abandoned _____

Date

AUG 2 1939 19

S. J. LEWIS Scout

Russell KANSAS

Map No. _____ Sec. 18 Twp. 15 R. 13W

Well No. 5 Meharg
Southern Company

Contractor

COMPLETED

SE NE NE

SECTION PLAT

990 Ft. from N. Line
_____ Ft. from S. Line
330 Ft. from E. Line
_____ Ft. from W. Line

CORALENA POOL

Location _____

RECORD

Cased _____ in., _____ ft.
Sand _____
Gas _____
Oil _____
Total Depth 3254 1/2

Rig up _____

Drilling and Remarks:

Cor 3250
5" C 3251
2000 acid
Pump 201 Pot.

PRODUCTION

1st 24 hrs. Nat. _____
1st 24 hrs. after shot _____
Gas _____ Cu. Ft.
Dry Hole _____
Abandoned _____

Date

SEP 13 1939 19

S. J. LEWIS Scout

Sec. 18 Twp. 15 R. 13-W

Well No. #5 Meharg Farm

Southern Company

(Coralena)


990 Ft. from N. Line

Ft. from S. Line

330 Ft. from E. Line

Ft. from W. Line

Elev. 1802

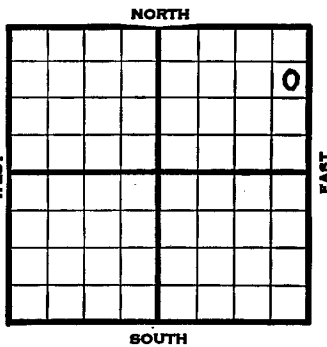

1939	REPORT
8/2	Rotary.
8/3	"
8/10	8" - 263' Anhy 805' Drlg. 1975'
8/17	Coring 2983'
8/24	Lans. 2985' S.O. 3028-31' Arb. 3250' 5" - 3251' T.D. 3252' RUST.
8/31	T.D. 3254½' 600' oil 8 hrs. Shut down.
9/7	1000 acid. No test.
9/13	Arb. 3250' 5" - 3251' T.D. 3254½' 2000 acid. Potential 201 bbls., pump.
	COMPLETED

Section 18 Township 15 Range 13-W

Well No. #5 Meharg

Company Southern

NORTH Coralena Pool

