

Russell KANSAS

Map No. 73 Sec. 18 Twp. 15 R. 13WWell No. 1 MehargW. I. Southern

Company

Contractor

FIRST REPORT

SECTION PLAT

NE/C

330 Ft. from N. Line

Ft. from S. Line

330 Ft. from E. Line

Ft. from W. Line

			0

Location

RECORD

Cased 5 in., 3225 ft.

Sand

Gas

Oil

Total Depth

PRODUCTION

1st 24 hrs. Nat.

1st 24 hrs. after shot

Gas Cu. Ft.

Dry Hole

Abandoned

Rig up

Drilling and Remarks:

OWDD-OTD 2990

Arb. 3225 T.D.

5" 3225

WOC N.S.

Date

APR 27 1938

19

H. D. Hatfield Scout

Russell KANSAS

Map No. 73 Sec. 18 Twp. 15 R. 13WWell No. 1 MehargW. I. Southern

Company

Contractor

COMPLETED

SECTION PLAT

NE/C

330 Ft. from N. Line

Ft. from S. Line

330 Ft. from E. Line

Ft. from W. Line

			0

Location

RECORD

Cased 5 in., 3225 ft.Sand Arb 3225

Gas

Oil

Total Depth 3229

PRODUCTION

1st 24 hrs. Nat.

1st 24 hrs. after shot

Gas Cu. Ft.

Dry Hole

Abandoned

Rig up

Drilling and Remarks:

1000 acidPOT 1886Plus 570 water

Date

MAY 10 1938

19

H. D. Hatfield Scout

O.W.W.O.

S-513-B

County	Russell	Elev.	1791 RB
Sec.	18	Twp.	15
Company	Carter Oil	Rge.	13W
Farm Name	E. Maharg	No.	1

TOPS	DEPTH	LOG	DATUM
Anh.			
Tr.			
H.			
Tr.			
Dg.			
B.L.			
L.			
K.C.	2960		
B.K.C.			
Ce.			
C.			
M.			
M.			
K.			
Mz.			
Mq.			
V.			
S.			
S.			
A.	3225		
R.			
Pf.			
G.			
T.D.	3229		

Loc. in Sec. NE NE NE
(O.W.W.O.)
Geol. W.W.O.
Contr.
Pool
Trapp
No. 20-48
FIRST REPORT
COMPLETE

Date Comm. OLD INFO: 5" @ 3225, was Arb. prod.
NEW INFO: PB TD 3201, 16/3035-39, 32/3056-64, 3000 Acid total, P 23 BOPD + 4 BOPD.
COMPLETE

KANSAS

Russell

Map No. Sec. 18 Twp. 15 R. 13W

Well No. 1 ~~Weborg~~ MEHARG Farm

Southern Oil Company


330 Ft. from N. Line

Ft. from S. Line

330 Ft. from E. Line

Ft. from W. Line

Elev. 1791

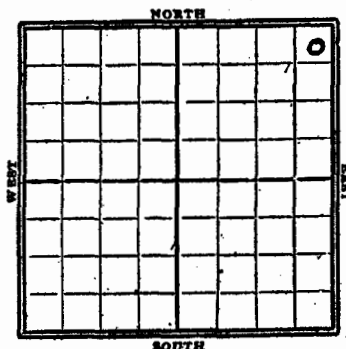

Date	REPORT
1936	O. W. D. D
12-9	Location
12/17	Rigging up.
12/24	10" @ 210'. WOC.
12/29	Drlg. 650'.
1937	
1/7	Drlg. 2800'.
1/14	8" @ 2808'. RUST.
1/21	" " "
1/28	Drlg. 2940'.
2/4	Lansing 2960 Pay 2988-90'
	TD 1800' oil in hole
2/10	Lansing 2960'.
	T. D. 2990'.
	5000 acid.
	Potential 776.
	COMPLETED
	OVER

1938

O. W. D. D

4/27

Old T.D. 2990'.

Arb. 3225' T.D.

5" @ 3225'.

WOC. No show.

5/6

T.D. 3229'. Pump 405 oil in
16 hrs. 6% water.

1000 acid.

5/10

5" @ 3225'.

Arb. 3225'.

T.D. 3229'.

1000 acid.

Potential 1886 bbls.

Plus 5% water.

COMPLETED

Russell
KANSAS

Section 18 Township 15 Range 13 -W

Well Number 1 ~~Waberg~~ MEHARG

Company Southern Oil

