

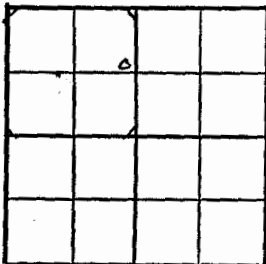
Kansas

Map No. K73 Sec. 18 Twp. 15 R. 13WWell No. 1 KrugC. Kessinger Company**FIRST REPORT**

Contractor

SE NE NW

## SECTION PLAT

990 Ft. from N. Line       Ft. from S. Line330 Ft. from E. Line       Ft. from W. Line

Russell County

Location

Rig up

Drilling and Remarks:

Rig

## RECORD

Cased        in.,        ft.

Sand

Gas

Oil

Total Depth

## PRODUCTION

1st 24 hrs. Nat.

1st 24 hrs. after shot

Gas        Cu. Ft.

Dry Hole

Abandoned

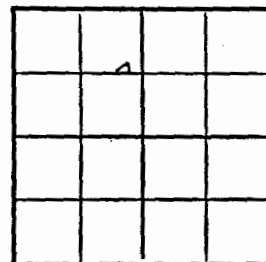
Date

MAR 26 1947 19 S. J. LEWIS ScoutMap No. 73 Sec. 18 Twp. 15 R. 13WWell No. 1 KrugC. Kessinger Company**COMPLETE**

Contractor

SE NE NW

## SECTION PLAT

990 Ft. from N. Line       Ft. from S. Line330 Ft. from E. Line       Ft. from W. Line

Russell County

Location

Rig up

Drilling and Remarks:

*C. K. 18**5' 6 3/16**Pump 80 BX**40 I.M.*

## RECORD

Cased        in.,        ft.

Sand

Gas

Oil

Total Depth 3221

## PRODUCTION

1st 24 hrs. Nat.

1st 24 hrs. after shot

Gas        Cu. Ft.

Dry Hole

Abandoned

Date

SEP 3 1947 19 S. J. LEWIS Scout

Russell KANSAS ✓

Sec. 18 Twp. 15E R. 13W

Well No. 1 Krug Farm

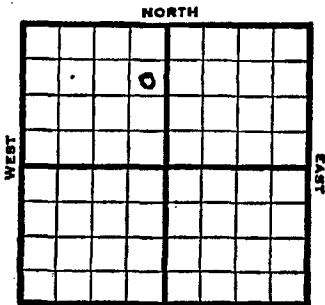
C. Kessinger Company  
Trapp Pool

990 Ft. from N. Line

Ft. from S. Line

330 Ft. from E. Line

Ft. from W. Line



SE NE NW

Elev. 1845'

SOUTH

1947 REPORT

|      |                                                                     |
|------|---------------------------------------------------------------------|
| 3/26 | Rig                                                                 |
| 4/2  | Rig                                                                 |
| 4/9  | Drlg 225'                                                           |
| 4/15 | 15" @ 270'<br>12" @ 487'<br>10" @ 849'<br>Drlg. 875'                |
| 4/23 | Drlg 2005'                                                          |
| 4/29 | 2489' CO<br>Drlg. 2489'                                             |
| 5/7  | Lans 3049<br>Arb 3321<br>5" @ 3324<br>TD 3329'<br>2200' oilin 2 hrs |
| 5/13 | Lansing 3049'<br>Arbuckle 3313'<br>Drlg. 3314'                      |
| 5/20 | TD 3321'<br>5" @ 3316'<br>Pump 6 bbls oil FH 24 hrs                 |
| 5/27 | " "                                                                 |
| 6/3  | TD 3327'                                                            |
| 6/10 | " " OVER                                                            |

1947

6/17 TD 3327'

6/24 "

7/1 "

7/8 "

7-16 "

7/22 "

7/29 "

8/6 "

8/13 "

8/20 "

8/27 "

9/3 Arb. 3313'

5" @ 3316'

Pump 30 Pot

40.9 Gr.

TD 3321'

COMPLETED

**Russell**

**FORM 51 IOM 12-46 PETROL**

Company C. Kessinger

