


County **Russell** State **Kansas**
 Sec. **18** (Blk. Twp.) **18** (Sur. Rge.) **13W** Map No.
 Operator **K-N-C Petroleum Inc.**
 Well No. **4** Farm **Krug**
 Elev. **1848** Location **SE NW NW**

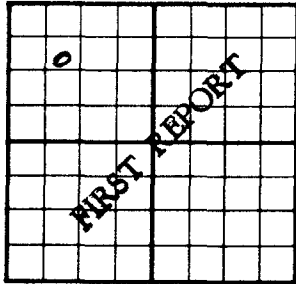


990 Ft. From **N** Line **NW**
990 Ft. From **W** Line Quarter
 Ist. Report **MAR 12 1952**
 Completion
 Remarks
Stearns - Contr.
 Spudding Date **2-27-52**

Drlg. Data

Drlg.

J. G. McGEHEE

County **Russell** State **Kansas**
 Sec. **18** (Blk. Twp.) **15** (Sur. Rge.) **13W** Map No.
 Operator **K-N-C Petroleum Inc.**
 Well No. **4** Farm **Krug**
 Elev. **1848** Location **SE NW NW**

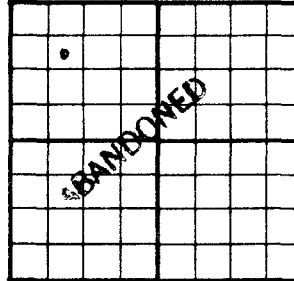

990 Ft. From **N** Line **NW**
990 Ft. From **W** Line Quarter
 Ist. Report
 Completion **MAY 7 1952**
 Remarks
Stearns Drlg. - Contr.
 Spudding Date **2-27-52**

Drlg. Data D & A TD 3344

12" @ 397 10" @ 858 8" @ 2584

Anhy 857 Tarkio 2435-50 Lans. 3055

Arb. 3340 5" @ 3300 TD 3340 DD 3344


HFW D & A

J. G. McGEHEE

FORM 252-B
10M 10-50 PETROL
Russell
Sec. 18 Twp. 15 R. 13W
Well No. #4 Krug Farm
K N C Petroleum Inc. Company
Stearns Contractor

990 Ft. from N. Line
Ft. from S. Line
Ft. from E. Line
990 Ft. from W. Line

SE NW NW

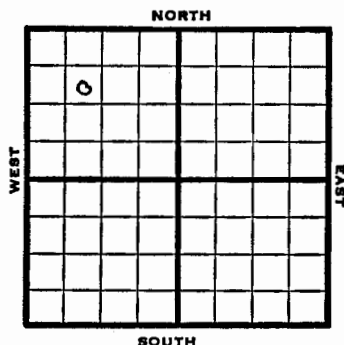

1952 Elev. 1848' REPORT

3/12 Spud 2-27-52
Drlg.
3/19 12" @ 397
10" @ 858
8" @ 2584
Drlg. 2590'
3/25 Anhy 857 Tarkio 2435-50
Drlg. 3020'
4/1 Lans. 3055
Drlg. 3272'
4/9 NR
4/23 NR
4/30 TD 3340' 5" @ 3300'
5/7 Spud 2-27-52
D & A TD 3344' 12" @ 397
10" @ 858 8" @ 2584 Anhy 857'
Tarkio 2435-50' Lans. 3055'
Arb. 3340' 5" @ 3300 TD 3340
DD 3344' HFW D & A

ABANDONED

FORM 51 25M 8-50 WESTERN
Russell KANSAS
Section 18 Township 15 Range 13 W
Well No. #4 Krug
Company K-N-C Petroleum Inc.

