

Trapp Pool

Map No. _____ Sec. 18 Twp. 15 R. 14W

Well No. 2 Krug

C. G. Kessinger Company

FIRST REPORT

Contractor

NE SE NW

SECTION PLAT

_____ Ft. from N. Line

990 Ft. from S. Line

330 Ft. from E. Line

_____ Ft. from W. Line

Russell County

Location X

Rig up _____

Drilling and Remarks:

RECORD

Cased _____ in., _____ ft.

Sand _____

Gas _____

Oil _____

Total Depth _____

PRODUCTION

1st 24 hrs. Nat. _____

1st 24 hrs. after shot _____

Gas _____ Cu. Ft.

Dry Hole _____

Abandoned _____

Date

JUN 4 1947 19 S. J. LEWIS Scout

Trapp Pool

Map No. 73 Sec. 18 Twp. 15 R. 13W

Well No. 2 Krug

C. G. Kessinger Company

CORRECTION

Contractor

NE SE NW

SECTION PLAT

_____ Ft. from N. Line

990 Ft. from S. Line

330 Ft. from E. Line

_____ Ft. from W. Line

Russell County

Location _____

Rig up _____

Drilling and Remarks:

Reported

18-15-14W

RECORD

Cased _____ in., _____ ft.

Sand _____

Gas _____

Oil _____

Total Depth _____

PRODUCTION

1st 24 hrs. Nat. _____

1st 24 hrs. after shot _____

Gas _____ Cu. Ft.

Dry Hole _____

Abandoned _____

Date

JUN 11 1947 19 S. J. LEWIS Scout

KANSAS Russell

13 W


Sec. 18 Twp. 15 R. 13 W
Well No. 2 Krug Farm _____
C. G. Kessinger Company

_____ Ft. from N. Line

990 Ft. from S. Line

330 Ft. from E. Line

_____ Ft. from W. Line

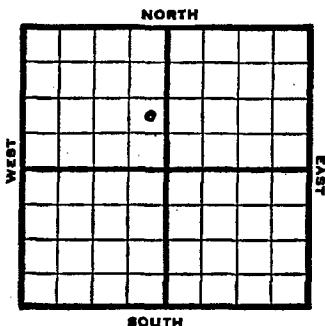

NE SE NW

1947 Elev. 1856' REPORT

6/4	Location
6/10	"
6/17	"
6/24	"
7/1	"
7/8	"
7-16	Rig
7/22	"
7/29	15" @ 330' 13" @ 495' Drlg. 800'
8/6	10" @ 859' Drlg 1665'
8/13	Drlg. 2350'
8/20	8" @ 2483, Drlg. 2675'
8/27	Lansing 3053' TD 3088' Run 5"
9/3	TD 3093 7" @ 3085 pump 9 bbls. oil PH 17 hrs. 2500 acid

OVER

1947

9/10 TD 3093'
7" @ 3085, Pump 9 bbls oil
PH-17 hrs, 2500 acid

9/17

9/24

10/1 Lansing 3046
7" @ 3085
2500 acid
Pump 360 Pot
TD 3093
Gravity 40.9


COMPLETED

Map No. 73 Sec. 18 Twp. 15 R. 13WWell No. 2 KrugC. G. Kessinger Company

COMPLETE

Contractor

NE SE NW

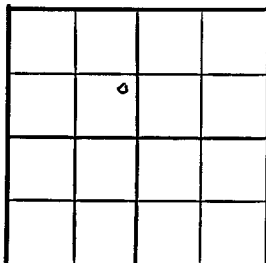E. 1/8
SECTION PLAT Ft. from N. Line290 Ft. from S. Line330 Ft. from E. Line Ft. from W. Line

Russell County

Location

Rig up

Drilling and Remarks:

Lane 30467" C 30852500 CecilProd 060 R840 lbs.

RECORD

Cased in., ft.Sand Gas Oil Total Depth 3093

PRODUCTION

1st 24 hrs. Nat. 1st 24 hrs. after shot Gas Cu. Ft.Dry Hole Abandoned

Date

OCT 1 1947 19 S. J. LEWIS Scout

Russell

FORM 51 10M 12-46 PETROL
KANSASSection 18 Township 15 Range 13WWell No. 2 KrugCompany C. G. Kessinger