

Map No. \_\_\_\_\_ Sec. 18 Twp. 15 R. 13W

Well No. 2 Meharg


National Marketing Company

FIRST REPORT

Contractor

NE SW NE

SECTION PLAT

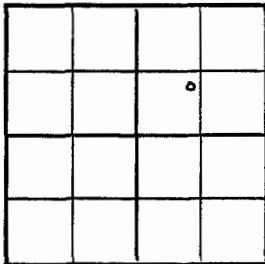

Ft. from N. Line

990 Ft. from S. Line

Ft. from E. Line

990 Ft. from W. Line

Russell County

Location X

Rig up

Drilling and Remarks:

## RECORD

Cased in, ft.

Sand

Gas

Oil

Total Depth

## PRODUCTION

1st 24 hrs. Nat.

1st 24 hrs. after shot

Gas Cu. Ft.

Dry Hole

Abandoned

Date

JUN 9 1948 19 S. J. LEWIS Scout

Russell County Kansas State

Map No. 73 Sec. 18 Twp. 15 R. 13W

Well No. 2 Meharg


National Marketing Company

COMPLETE

Contractor

NE SW NE

SECTION PLAT

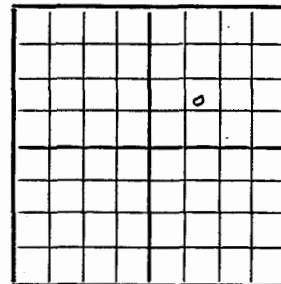

Ft. from N. Line

990 Ft. from S. Line

Ft. from E. Line

990 Ft. from W. Line

Trapp Pool

Remarks:

Cased 3280

4" @ 3292

YD 3294

Pump 25 oil. Rod

40' 3/4"

Date

SEP 22 1948

Scout

S. J. LEWIS

Russell

✓

Sec. 18 **KANSAS** Twp. 15 R. 13W

Well No. #2 Meharg Farm

National Marketing Company

Trapp Pool


Ft. from N. Line

990' Ft. from S. Line

Ft. from E. Line

990' Ft. from W. Line

NE SW NE

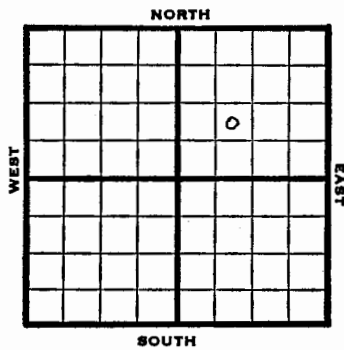1948 **Ele 1834' REPORT**

6/9 Location

6/16 "

6/23 Drlg 350

6/29 12" @ 430'

10" @ 820'

Drlg. 1210'

7/8 Drlg 2150'

7/14 Drlg 2440'

7/21 8" @ 2530'

7/28 8" @ 2509'

Drlg 2810'

8/4 Topeka 2752'

Landing 3027'

Drlg. 3130'

8/11 Arbuckle 3280'

TD 3294

4" @ 3292'

8/18 1500' oil 12 hrs.

8/25 "

9/1 "

9/8 "

9/14 "

9/22 Arb. 3280'

4" @ 3292'

TD 3294'

Pump 25 oil Pot **COMPLETED**

40' Gr/ Comp

**KANSAS**

Russell

Section 18 Township 15 Range 13W

Well No. #2 Meharg

Company National Marketing

