

KANSAS Kansas Pool Name Trapp
Map No. 73 Sec. 18 Twp. 15 R. 13W
Well No. 6 Meharg

Co-op _____ Company _____
FIRST REPORT Contractor _____

NE NW SE

SECTION PLAT

330 Ft. from N. Line
_____ Ft. from S. Line
_____ Ft. from E. Line
990 Ft. from W. Line

Russell County

Location X
Rig up _____
Drilling and Remarks:

RECORD
Cased _____ in., _____ ft.
Sand _____
Gas _____
Oil _____
Total Depth _____

PRODUCTION
1st 24 hrs. Nat. _____
1st 24 hrs. after shot _____
Gas _____ Cu. Ft.
Dry Hole _____
Abandoned _____

Date DEC 28 1945 19 _____ S. J. LEWIS Scout

KANSAS Kansas Pool Name Trapp
Map No. 73 Sec. 18 Twp. 15 R. 13W
Well No. 6 MeHarg

Co-op _____ Company _____
COMPLETED Contractor _____

NE NW SE

E11806
SECTION PLAT

330 Ft. from N. Line
_____ Ft. from S. Line
_____ Ft. from E. Line
990 Ft. from W. Line

Russell County

Location _____
Rig up _____
Drilling and Remarks:

Same 2997
QLY 3254
5' 03254
Pump 187 Rd

RECORD
Cased _____ in., _____ ft.
Sand _____
Gas _____
Oil _____
Total Depth 3254

PRODUCTION
1st 24 hrs. Nat. _____
1st 24 hrs. after shot _____
Gas _____ Cu. Ft.
Dry Hole _____
Abandoned _____

Date FEB 13 1946 19 _____ S. J. LEWIS Scout

Sec. 18 Twp. 15 R. 13^W

Well No. #6 Meharg Farm

Co-op Company


Trapp

330 Ft. from N. Line

Ft. from S. Line

Ft. from E. Line

990 Ft. from W. Line

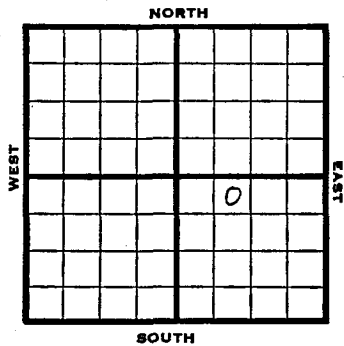

NE NW SE

1945 Elev. 1806' REPORT

12/28 Location

1946
1/10 8" - 800' Anhy 800'
Drlg. 1523'

1/17 Drlg. 2625'

1/24 Lans. 2997' Arb. 3254'
5" - 3254' T.D. 3254'
RUST.

1/31 T.D. 3258' 2700' oil 12 hours.

2/7 " " "

2/13 Lans 2997
Arb. 3254
5" @ 3254
TD 3258'
Pump 187 Pot.
Grav. 39.0

COMPLETED

Section 18 Township 15 Range 13-W

Well No. #6 Meharg

Company Co-op

