

Kansas Pool Name Trapp

Map No. 73 Sec. 18 Twp. 15 R. 13W

Well No. 2 Keil

Phil-Han Company

FIRST REPORT Contractor

NE SW

SECTION PLAT

330 Ft. from N. Line

\_\_\_\_\_ Ft. from S. Line

330 Ft. from E. Line

\_\_\_\_\_ Ft. from W. Line


Russell County

Location \_\_\_\_\_

Rig up \_\_\_\_\_

Drilling and Remarks:  
8"-514 WOC

RECORD

Cased \_\_\_\_\_ in., \_\_\_\_\_ ft.

Sand \_\_\_\_\_

Gas \_\_\_\_\_

Oil \_\_\_\_\_

Total Depth \_\_\_\_\_

PRODUCTION

1st 24 hrs. Nat. \_\_\_\_\_

1st 24 hrs. after shot \_\_\_\_\_

Gas \_\_\_\_\_ Cu. Ft.

Dry Hole \_\_\_\_\_

Abandoned \_\_\_\_\_

Date

JUN 13 1945 19 S. J. LEWIS Scout

KANSAS Pool Name Trapp

Map No. 73 Sec. 18 Twp. 15 R. 13W

Well No. 2 Keil

Phil-Han Company

ABANDONED Contractor

NE SW

SECTION PLAT

330 Ft. from N. Line

\_\_\_\_\_ Ft. from S. Line

330 Ft. from E. Line

\_\_\_\_\_ Ft. from W. Line


Russell County

Location \_\_\_\_\_

Rig up \_\_\_\_\_

Drilling and Remarks:  
Oil 3298

RECORD

Cased \_\_\_\_\_ in., \_\_\_\_\_ ft.

Sand \_\_\_\_\_

Gas \_\_\_\_\_

Oil \_\_\_\_\_

Total Depth 3307

PRODUCTION

1st 24 hrs. Nat. \_\_\_\_\_

1st 24 hrs. after shot \_\_\_\_\_

Gas \_\_\_\_\_ Cu. Ft.

Dry Hole \_\_\_\_\_

Abandoned \_\_\_\_\_

Date

AUG 29 1945 19 S. J. LEWIS Scout

KANSAS

Russell

Sec. 18 Twp. 15 R. 13W

Well No. 2 Keil Farm

Phil-Han Company


Trapp  
330 Ft. from N. Line

Ft. from S. Line

330 Ft. from E. Line

Ft. from W. Line

NE SW Elev. 1848

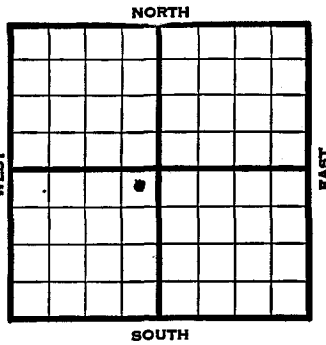

REPORT

1945	
6/13	8" @ 514 WOC
6/21	Anhy 870 Drlg. 2850
6/28	Arb 3298 TD 3306 5" @ 3302 RUST
7/3	Arb. 3298 TD 3306 5" @ 3302' RUST
7/11	" " " "
7/19	TD 3307 1250 acid.
7/26	" "
8/1	TD 3307-1250 acid
8/8	" " " "
8/15	" " " "
8/22	Shut down
8/29	Arb. 3298 TD 3307'

ABANDONED

KANSAS

Russell County

Section 18 Township 15 Range 13W

Well No. 2 Keil

Company Phil-Han

