

KANSAS

Map No. 79 Sec. 18 Twp. 15 R. 13W

Well No. 1 Kiel

Pryor & Lockhart Company

FIRST REPORT Contractor

SW SE SW

SECTION PLAT

Ft. from N. Line
 330 Ft. from S. Line
 990 Ft. from E. Line
 Ft. from W. Line

Trapp Pool

Location
 Rig up
 Drilling and Remarks:

Cable Rig

RECORD

Cased in. ft.
 Sand
 Gas
 Oil
 Total Depth

PRODUCTION

1st 24 hrs. Nat.
 1st 24 hrs. after shot
 Gas Cu. Ft.
 Dry Hole
 Abandoned

Date

DEC 8 1943 19 S. J. LEWIS Scout

KANSAS

Map No. 79 Sec. 18 Twp. 15 R. 13W

Well No. 1 Kiel

Pryor & Lockhart Company

COMPLETED Contractor

SW SE SW

SECTION PLAT

Ft. from N. Line
 330 Ft. from S. Line
 990 Ft. from E. Line
 Ft. from W. Line

Trapp Pool

Location
 Rig up
 Drilling and Remarks:

Ca 43228
5'03288

Pump 171 in 67 90 water
PdY.

405 Bu

RECORD

Cased in. ft.
 Sand
 Gas
 Oil
 Total Depth *2225*

PRODUCTION

1st 24 hrs. Nat.
 1st 24 hrs. after shot
 Gas Cu. Ft.
 Dry Hole
 Abandoned

Date

MAR 1 1944 19 S. J. LEWIS Scout


KANSAS

Russell

Sec. 18 Twp. 15 R. 13 W

Well No. #1 Kiel Farm
Pryor & Lockhart Company

_____ Ft. from N. Line
330 Ft. from S. Line
990 Ft. from E. Line
_____ Ft. from W. Line

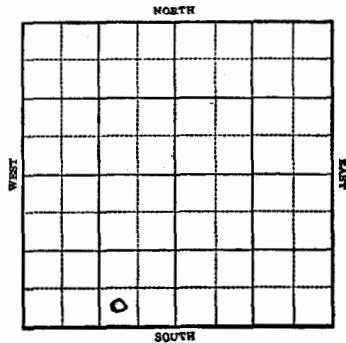

1943 REPORT

12-8	Cable Rig
12-15	"
12/22	"
12/29	Rigging up
1944	
1-5	" "
1-12	" "
1/19	10" @ 845 Drlg. 1650'
1/26	8" @ 2342 Drlg. 2400'
2/2	Drlg. 2524 8" @ 2520
2/8	Drlg. 2975'
2/15	Lans 3-24 7" @ 3024 3150 UR 7"
2/23	Arb 3273-95 TD SO 5" @ 3288 WOC.
3/1	5" @ 3288 Arb 3273 TD 3295 Pump 171 oil & 90 Water Pot. Gravity 40.5
COMPLETED	

KANSAS

Russell

Section 18 Township 15 Range 13-W

Well No. #1 Kiel

Company Pryor & Lockhart

