

Map No. _____ Sec. 18 Twp. 15 R. 13W

Well No. 5 Krug "A"

Bridgeport _____ Company _____

FIRST REPORT _____ Contractor _____

SE NW SW


SECTION PLAT

990 _____ Ft. from N. Line

_____ Ft. from S. Line

_____ Ft. from E. Line

990 _____ Ft. from W. Line

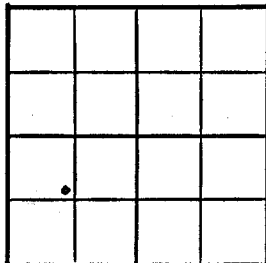

Russell County

Location _____

Rig up _____

Drilling and Remarks:

R U R

RECORD

Cased _____ in., _____ ft.

Sand _____

Gas _____

Oil _____

Total Depth _____

PRODUCTION

1st 24 hrs. Nat. _____

1st 24 hrs. after shot _____

Gas _____ Cu. Ft.

Dry Hole _____

Abandoned _____

Date

OCT 27 1948 19

S. J. LEWIS Scout

Map No. 73 Sec. 18 Twp. 15 R. 13W

Well No. 5 Krug "A"

Bridgeport _____ Company _____

COMPLETE _____ Contractor _____

SE NW SW


SECTION PLAT

990 _____ Ft. from N. Line

_____ Ft. from S. Line

_____ Ft. from E. Line

990 _____ Ft. from W. Line

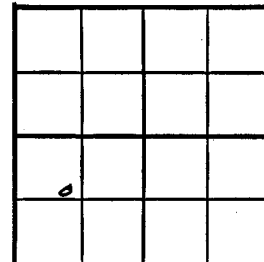

Russell County

Location _____

Rig up _____

Drilling and Remarks:

Cor 330?

5' Cor 330?

5000000

Depth 2647 ft

40 E 1/4

RECORD

Cased _____ in., _____ ft.

Sand _____

Gas _____

Oil _____

Total Depth 2647 ft

PRODUCTION

1st 24 hrs. Nat. _____

1st 24 hrs. after shot _____

Gas _____ Cu. Ft.

Dry Hole _____

Abandoned _____

Date

DEC 8 1948 19

S. J. LEWIS Scout

KANSAS

Russell

Sec. 18 Twp. 15 R. 13W

Well No. #5 Krug "A" Farm

Bridgeport

Company


Trapp Pool

990' Ft. from N. Line

Ft. from S. Line

Ft. from E. Line

990' Ft. from W. Line

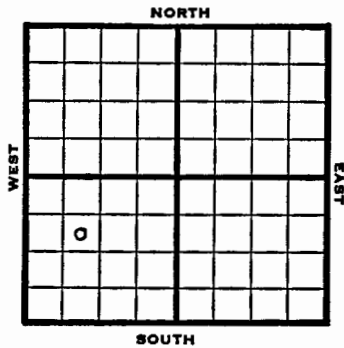

SE NW SW

REPORT

1948 Eli 1862'

10/27 RUR
11/3 8" @ 262'
Drlg. 2820'

11/10 Topeka 2758'
Lansing 3052'
Arbuckle 3307'
TD 3311'
5" @ 3309'

11/16 TD 3315'
500 acid
Swb 35 bbls oil PH, 4 hrs.

11/23 "
11/30 "

12/8 TD 3315'
Arb 3307'
5" @ 3309'
500 acid
Depth Pot 2647 Oil
40' Grl

Comp
COMPLETED

KANSAS Russell

Section 18 Township 15 Range 13W

Well No. 5 Krug "A"

Company Bridgeport

Trapp Pool
NORTH

