

Map No. _____ Sec. 18 Twp. 15 R. 13W

Well No. 1 Krug "A"

Bridgeport _____ Company _____

FIRST REPORT Contractor _____

SE SW SW


SECTION PLAT

_____ Ft. from N. Line

330 Ft. from S. Line

_____ Ft. from E. Line

990 Ft. from W. Line

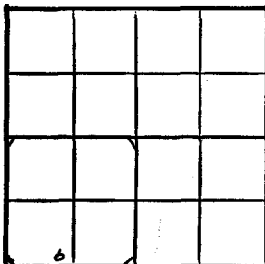

Russell County

Location _____

Rig up _____

Drilling and Remarks:

R U R

RECORD

Cased _____ in., _____ ft.

Sand _____

Gas _____

Oil _____

Total Depth _____

PRODUCTION

1st 24 hrs. Nat. _____

1st 24 hrs. after shot _____

Gas _____ Cu. Ft.

Dry Hole _____

Abandoned _____

Date _____

DEC 10 1947 19

S. J. LEWIS

Scout

Map No. 73 Sec. 18 Twp. 15 R. 13W

Well No. 1 Krug "A"

Bridgeport _____ Company _____

COMPLETE Contractor _____

SE SW SW


SECTION PLAT

_____ Ft. from N. Line

330 Ft. from S. Line

_____ Ft. from E. Line

990 Ft. from W. Line

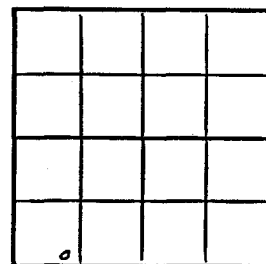

Russell County

Location _____

Rig up _____

Drilling and Remarks:

*Cut 3298
5" @ 299
500 acid
Pump 398 Pdy*

35-1/2

RECORD

Cased _____ in., _____ ft.

Sand _____

Gas _____

Oil ☒

Total Depth 3302

PRODUCTION

1st 24 hrs. Nat. _____

1st 24 hrs. after shot _____

Gas _____ Cu. Ft.

Dry Hole _____

Abandoned _____

Date _____

9-11
DEC 23 1947 19

S. J. LEWIS

Scout

KANSAS

Russell

Sec. 18 Twp. 15 R. 13-W

Well No. #1 Krug "A" Farm

Bridgeport Company

Trapp Pool


Ft. from N. Line

530' Ft. from S. Line

Ft. from E. Line

990' Ft. from W. Line

SE SW SW

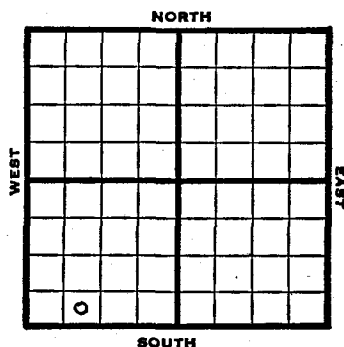

1947	Elev. 1859' REPORT
12/10	RUR
12/17	8" @ 258'
12/30	Drlg. 3250'
1948	
1/7	Topeka 2750' Lansing 3040' Arbuckle 3298' TD 3302' 5" @ 3299' 500' oil 4 hrs.
1/14	"
1/21	"
1/26	500 acid Pump 92 bbls oil 8 hrs.
2/4	"
2/11	Arb. 3298' 5" @ 3299' 500 acid Pump 398 Pot Gr. 38.6 TD 3302' Comp.
COMPLETED	

KANSAS

Section 18 Township 15 Range 13W

Well No. 1 Krug A

Company Bridgeport

