

Trapp Pool

Map No. \_\_\_\_\_ Sec. 18 Twp. 15 R. 13W

Well No. 2 Krug "A"

Bridgeport Company

FIRST REPORT

Contractor

SE SW

SECTION PLAT

\_\_\_\_\_ Ft. from N. Line

330 Ft. from S. Line

330 Ft. from E. Line

\_\_\_\_\_ Ft. from W. Line


Russell County

Location X

RECORD

Cased \_\_\_\_\_ in., \_\_\_\_\_ ft.

Sand \_\_\_\_\_

Gas \_\_\_\_\_

Oil \_\_\_\_\_

Total Depth \_\_\_\_\_

Drilling and Remarks:

PRODUCTION

1st 24 hrs. Nat. \_\_\_\_\_

1st 24 hrs. after shot \_\_\_\_\_

Gas \_\_\_\_\_ Cu. Ft.

Dry Hole \_\_\_\_\_

Abandoned \_\_\_\_\_

Date

JAN 28 1948 19

S. J. LEWIS Scout

Trapp Pool

Map No. 73 Sec. 18 Twp. 15 R. 13W

Well No. 2 Krug "A"

Bridgeport Company

COMPLETE

Contractor

SE SW

SECTION PLAT

\_\_\_\_\_ Ft. from N. Line

330 Ft. from S. Line

330 Ft. from E. Line

\_\_\_\_\_ Ft. from W. Line


Russell County

Location \_\_\_\_\_

RECORD

Cased \_\_\_\_\_ in., \_\_\_\_\_ ft.

Sand \_\_\_\_\_

Gas \_\_\_\_\_

Oil

Total Depth 3274

Drilling and Remarks:

*Per 3269  
5" C 3270  
1000000  
Depth 3274*

PRODUCTION

1st 24 hrs. Nat. \_\_\_\_\_

1st 24 hrs. after shot \_\_\_\_\_

Gas \_\_\_\_\_ Cu. Ft.

Dry Hole \_\_\_\_\_

Abandoned \_\_\_\_\_

Date

JAN 1 1948 19

S. J. LEWIS Scout

Sec. 18 Twp. 15 R. 13W

Well No. #2 Krug "A" Farm \_\_\_\_\_

Bridgeport Company  
Trapp


\_\_\_\_\_ Ft. from N. Line

330 Ft. from S. Line

330 Ft. from E. Line

\_\_\_\_\_ Ft. from W. Line

SE SW

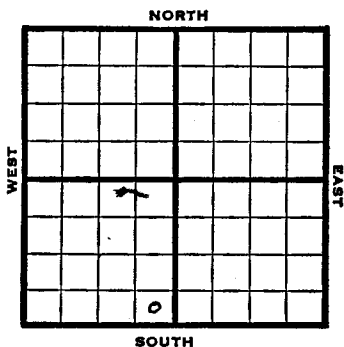


Section 18 Township 15 Range 13W

Well No. #2 Krug "A"

Company Bridgeport

NORTH

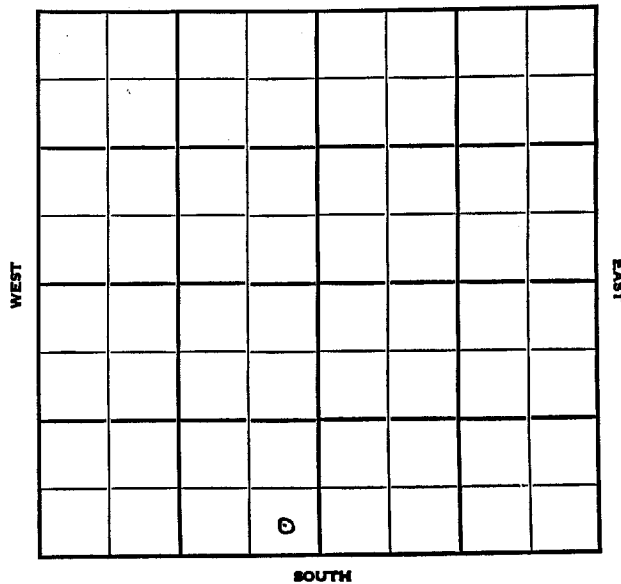

1948 Elev. 1833' REPORT

1/28 Location

2/4 8" @ 250'  
Drlg. 1865'

2/11 Lansing 3012'  
Arbuckle 3269-72' TD  
5" @ 3270'  
RUST

2/18 "

2/25 TD 3274'  
Swb 27½ bbls oil in 3 hrs.

3/3 "

3/10 "

3/17 "

3/24 "

3/31 "

4/7 1000 acid  
Pump 165 bbls. oil 12 hrs.

4/14 Arb. 3269' 5" @ 3270'  
1000 acid Depth Pot 958'  
40.9 Gr.  
TD 3274'  
Eomp.

**COMPLETED**