

KANSAS  
Map No. 73 Sec. 18 Twp. 15 R. 13W


Well No. 1 Meharg

N. Appleman & Nat'l Ref. Company  
FIRST REPORT

Contractor

SW SE

SECTION PLAT

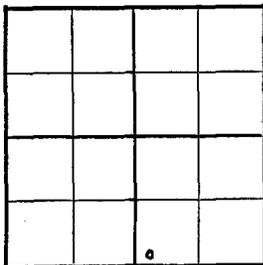

Ft. from N. Line  
330 Ft. from S. Line  
Ft. from E. Line  
330 Ft. from W. Line

Sellens Pool

Location	RECORD
Rig up	Cased _____ in., _____ ft.
Drilling and Remarks: Cable	Sand _____
	Gas _____
	Oil _____
	Total Depth _____
	PRODUCTION
	1st 24 hrs. Nat. _____
	1st 24 hrs. after shot _____
	Gas _____ Cu. Ft.
	Dry Hole _____
	Abandoned _____

Date

SEP 22 1943 19 S. J. LEWIS Scout

KANSAS  
Map No. 73 Sec. 18 Twp. 15 R. 13W

Well No. 1 Meharg


N. Appleman & Nat'l Ref. Company

COMPLETED

Contractor

SW SE

SECTION PLAT

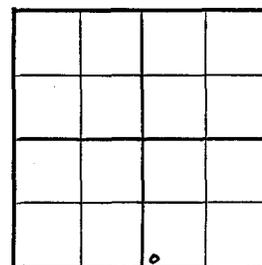

Ft. from N. Line  
330 Ft. from S. Line  
Ft. from E. Line  
330 Ft. from W. Line

Sellens Pool

Location	RECORD
Rig up	Cased _____ in., _____ ft.
Drilling and Remarks: Cased 3269 5" 3269 Pump 348 P.T. No. 2	Sand _____
	Gas _____
	Oil _____
	Total Depth 3285
	PRODUCTION
	1st 24 hrs. Nat. _____
	1st 24 hrs. after shot _____
	Gas _____ Cu. Ft.
	Dry Hole _____
	Abandoned _____

Date

JAN 19 1944 19 S. J. LEWIS Scout


KANSAS

Russell

Sec. 18 Twp. 15 R. 13-W

Well No. #1 Meharg Farm

N. Appleman & Nat'l Ref. Company

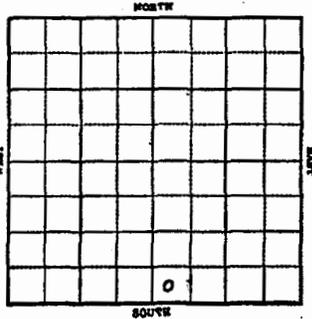

\_\_\_\_\_ Ft. from N. Line

330 Ft. from S. Line

\_\_\_\_\_ Ft. from E. Line

330 Ft. from W. Line

*Elev. 1831*

1944

1-5 3269 Corrected 5" @ 32 69 swb 25  
oil Ph 5 hrs.

1-12 " "

1/19

5" @ 3269  
Arb 3269  
TD 3285  
Pump 348 Pot.  
Gravity 40.1

**COMPLETED**

1943	REPORT
9/22	Cable
9/29	" Rig
10/6	" "
10/13	Spud
10/20	13" @ 340 Anhy 812 Drlg. 815'
10/27	Drlg. 1550' 10" @ 823'
11/3	Drlg. 2280'
11/10	8" @ 2439 Drlg. 2720'
11/17	Lans 3023 Arb 3280 TD 3285 2400' oil in 6 hrs. Run 5"
11/24	" " "
12 /1	Arb 3269 corrected 5" @ 3269 shot 25 oil P.H 5 hrs.
12/8	" "
12-15	" "
12/22	" "
12/29	" "

**OVER**

**KANSAS**  
FORM 51 5M PETROL

Russell

Section 18 Township 15 Range 13-W

Well No. #1 Meharg

Company N. Appleman & Nat'l Ref.

