

KANSAS
Map No. 73 Sec. 18 Twp. 15 R. 13W

Well No. 2 Meharg

N. Appleman et al.


Company

FIRST REPORT

Contractor

SW SE SE

SECTION PLAT

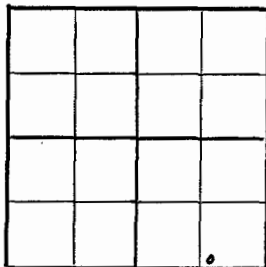

Ft. from N. Line

330 Ft. from S. Line990 Ft. from E. Line

Ft. from W. Line

Trapp Pool

Location

Rig up

Drilling and Remarks:

8" - 800 WOC

RECORD

Cased _____ in., _____ ft.

Sand _____

Gas _____

Oil _____

Total Depth _____

PRODUCTION

1st 24 hrs. Nat. _____

1st 24 hrs. after shot _____

Gas _____ Cu. Ft.

Dry Hole _____

Abandoned _____

Date

APR 12 1944

19

S. J. LEWIS Scout

KANSAS
Map No. 73 Sec. 18 Twp. 15 R. 13W

Well No. 2 Meharg

N. Appleman et al.


Company

COMPLETED

Contractor

SW SE SE

SECTION PLAT

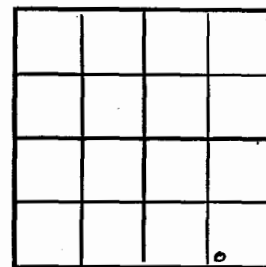

Ft. from N. Line

330 Ft. from S. Line990 Ft. from E. Line

Ft. from W. Line

Russell County

Location

Rig up

Drilling and Remarks:

Ce 8 32595 10 3259Pump 266 Bx40 2 8

RECORD

Cased _____ in., _____ ft.

Sand _____

Gas _____

Oil _____

Total Depth 1226

PRODUCTION

1st 24 hrs. Nat. _____

1st 24 hrs. after shot _____

Gas _____ Cu. Ft.

Dry Hole _____

Abandoned _____

Date

JUN 14 1944

19

S. J. LEWIS

Scout

Russell

Sec. 18 Twp. 15 R. 13W

Well No. #2 ~~Mekarg~~ Meharg Farm

N. Appleman et al. Company

Trapp Pool


Ft. from N. Line

330 Ft. from S. Line

990 Ft. from E. Line

Ft. from W. Line

elev. 1814

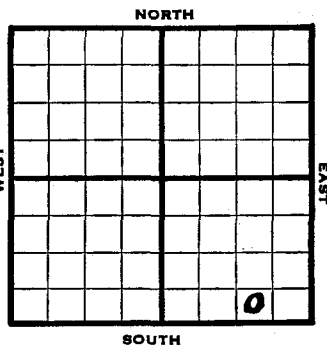

REPORT

1944	REPORT
4/12	8" @ 800 WOC
4/19	Drig. 2500'
4/26	Lans 3005 Arb 3256-58 TD SO Run Csg.
5/3	Arb 3259 Corrected TD 3261 5" @ 3259 Rust
5/10	1000' oil 1 hr 2700' oil in 6 hrs.
5/17	" " "
5/24	" " "
5/31	" " "
6/7	" " "
6/14	Arb. 3259 5" @ 3259 TD 3261 Pump 266 Pot 40.7 Grav.

COMPLETED

Russell

Section 18 Township 15 Range 13W

Well No. #2 ~~Mekarg~~ Meharg

Company N. Appleman et al.

