

County **Russell** State **Kansas**

Sec. **18** (**Bk.**) **15** (**Sur.**) **13W** Map No.

Operator **C R A**

Well No. **7** Farm **Maharg**

Elev. Location **NE SE SE**

FIRST REPORT

990 Ft. From **S** Line **SE**

330 Ft. From **E** Line Quarter

lst. Report **SEP 27 1950**


Completion

Remarks

Spudding Date **9-25-50**

Drig. Data Trapp Pool
drig. 802

J. E. TYRA

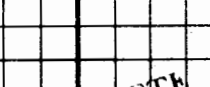County	Russell	State	Kansas
Sec.	18	(Blk. Twp.)	15 (Sur. Rge.) 13W Map No.
Operator	C R A		
Well No.	7	Farm	Maharg
Elev.	1808	Location	NE SE SE
			
990 Ft. From S Line		SE	
330 Ft. From E Line		Quarter	
1st. Report			
Completion		NOV 1 1950	
Remarks		Trapp Pool	
Spudding Date 9-25-50			

Drilg. Data Oil well TD 3262
8 5/8" @ 800 Heeb. 2931 Lans. 2997
Stain 3034-39 DST 3001-51 open 45 min.
Rec. 60' ocm Arb. 3260-62 TD 5" @ 3260
P/ 7 1/2 bo 1 hr. 5 bo 2nd hr
Comp. 66 bopd

J. E. TYRA

Russell **KANSAS**
15 13W ✓

Sec. 18 Twp. 15 R. 13W ✓

Well No. #7 *Maharg Meharg* Farm

C R A

Company

Trapp Pool

Contractor


Ft. from N. Line

990' Ft. from S. Line

330' Ft. from E. Line

Ft. from W. Line

NE SE SE

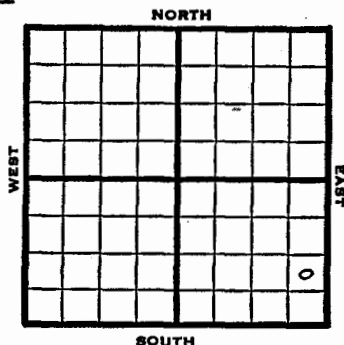

1950 Elev. 1808' **REPORT**

9/27 Spud 9-25-50

Drlg. 802'

11/1 Spud 9-25-50

Oil Well TD 3262'

8-5/8" @ 800' Heeb. 2931'

Lans. 2997' Stn 3034-39

DST 3001-51 opn 45 min.

Rec. 60' OCM Arb. 3260-62 TD

5" @ 3260

P/7½ BO 1 hr. 5 BO 2nd hr

Comp. 66 BOPD

COMPLETED

KANSAS Russell

Section 18 Township 15 Range 13W

Well No. #7 *Maharg Meharg*

Company C R A

