

Form 26 200 Bks 5-42 Petrol Russell
KANSAS
Map No. 73 Sec. 19 Twp. 15 R. 13W
Well No. 6 Gale Sellens
Coralena Company
FIRST REPORT Contractor

C S L NE NE

SECTION PLAT

990 Ft. from N. Line
Ft. from S. Line
660 Ft. from E. Line
Ft. from W. Line

Sellens Pool

Location

Rig up

Drilling and Remarks:

10" - 432 WOC

RECORD

Cased in, ft.

Sand

Gas

Oil

Total Depth

PRODUCTION

1st 24 hrs. Nat.

1st 24 hrs. after shot

Gas Cu. Ft.

Dry Hole

Abandoned

Date

DEC 8 1943 19

S. J. LEWIS Scout

Form 26 200 Bks 5-42 Petrol Russell
KANSAS
Map No. 73 Sec. 19 Twp. 15 R. 13W
Well No. 6 Gale Sellens
Coralena Company
COMPLETED Contractor

C S L NE NE

SECTION PLAT

990 Ft. from N. Line
Ft. from S. Line
660 Ft. from E. Line
Ft. from W. Line

Sellens Pool

Location

Rig up

Drilling and Remarks:

Cu 43204

5" 43204

Propr 201 208

40°/4

RECORD

Cased in, ft.

Sand

Gas

Oil

Total Depth 225'

PRODUCTION

1st 24 hrs. Nat.

1st 24 hrs. after shot

Gas Cu. Ft.

Dry Hole

Abandoned

Date

JAN 5 1944 19

S. J. LEWIS

Scout

KANSAS


Russell

Sec. 19 Twp. 15 R. 13 WWell No. #6 Gale Sellens Farm
Coralena Company990 Ft. from N. Line

Ft. from S. Line

660 Ft. from E. Line

Ft. from W. Line

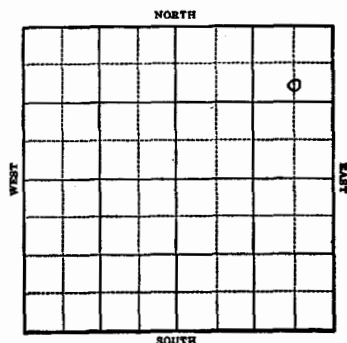

1943

R E P O R T

12-8 Location
10" at 432'
WOC

12-15 Drlg. 2715'

12/22 Topeka 2685
Dodge 2292
Lans 2978
Arb 3234-51 TD
5" @ 3234
Rust

12/29 1400' oil in 1½ hrs

1944
1/5 Arb 3234
5" @ 3234
TD 3251
Pump 201 Pot.
Gravity 40

COMPLETED

KANSAS

Russell

FORM 51 5M PETROL

Section 19 Township 15 Range 13-WWell No. # 6 Gale SellensCompany Coralena