

Map No. \_\_\_\_\_ Sec. 19 Twp. 15 R. 13W


Well No. 12 Gale Sellens

C R A Company

FIRST REPORT Contractor

NE NW

SECTION PLAT

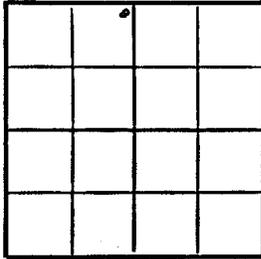

330 Ft. from N. Line

\_\_\_\_\_ Ft. from S. Line

330 Ft. from E. Line

\_\_\_\_\_ Ft. from W. Line

Russell County

Location \_\_\_\_\_

Rig up \_\_\_\_\_

Drilling and Remarks:

drlg. 470

RECORD

Cased \_\_\_\_\_ in., \_\_\_\_\_ ft.

Sand \_\_\_\_\_

Gas \_\_\_\_\_

Oil \_\_\_\_\_

Total Depth \_\_\_\_\_

PRODUCTION

1st 24 hrs. Nat. \_\_\_\_\_

1st 24 hrs. after shot \_\_\_\_\_

Gas \_\_\_\_\_ Cu. Ft.

Dry Hole \_\_\_\_\_

Abandoned \_\_\_\_\_

Date

JUN 25 1947 19 S. J. LEWIS Scout

Map No. 73 Sec. 19 Twp. 15 R. 13W


Well No. 12 Gale Sellens

C R A Company

COMPLETE Contractor

NE NW

E11816  
SECTION PLAT

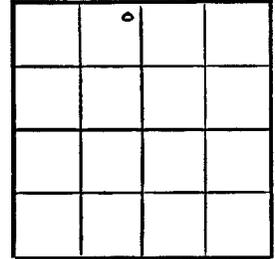

330 Ft. from N. Line

\_\_\_\_\_ Ft. from S. Line

330 Ft. from E. Line

\_\_\_\_\_ Ft. from W. Line

Russell County

Location \_\_\_\_\_

Rig up \_\_\_\_\_

Drilling and Remarks:

*Ar 63258*

*5" 02352*

*Prof Act.*

*5000 acid*

*Prod 132 oil + 25% gas*

*Act. 452*

RECORD

Cased \_\_\_\_\_ in., \_\_\_\_\_ ft.

Sand \_\_\_\_\_

Gas \_\_\_\_\_

Oil \_\_\_\_\_

Total Depth *232*

PRODUCTION

1st 24 hrs. Nat. \_\_\_\_\_

1st 24 hrs. after shot \_\_\_\_\_

Gas \_\_\_\_\_ Cu. Ft.

Dry Hole \_\_\_\_\_

Abandoned \_\_\_\_\_


Date

AUG 6 1947 19 S. J. LEWIS Scout

Sec. 19 Twp. 15 R. 13W

Well No. 12 Gale Sellens Farm  
C R A Company

Trapp Pool  
330 Ft. from N. Line  
Ft. from S. Line  
330 Ft. from E. Line  
Ft. from W. Line

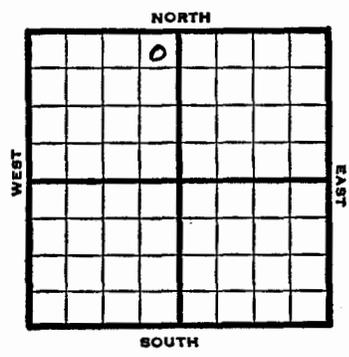

NE NW	REPORT
1947	Elev. 1816'
6/25	Drlg. 470'
7/1	8" @ 876' Lansing 2995' Drlg 3005'
7/8	Arbuckle 3258' TD 3352 5" @ 3352 RUST
7-16	18 shots 255-59 50 acid Swab 30 bbls oil PH - 2 Hrs.
7/22	"
7/29	"
8/6	Arb. 3258' 5" @ 3352' Perf. Arb. 5000 acid. Pump 132 oil / 25 % W Pot. Gr. 40.9 T.D. 3352' Completed
<b>COMPLETED</b>	

Section 19 Township 15 Range 13-W

Well No. #12 Gale Sellens

Company C R A  
Trapp

