

Map No. _____ Sec. 19 Twp. 15 R. 13W

Well No. 13 Gale Sellens

C R A Company

FIRST REPORT Contractor

NE NW NW

SECTION PLAT

330 Ft. from N. Line

_____ Ft. from S. Line

_____ Ft. from E. Line

990 Ft. from W. Line

Russell County

o			

Location _____

Rig up _____

Drilling and Remarks:

R U R

RECORD

Cased _____ in., _____ ft.

Sand _____

Gas _____

Oil _____

Total Depth _____

PRODUCTION

1st 24 hrs. Nat. _____

1st 24 hrs. after shot _____

Gas _____ Cu. Ft.

Dry Hole _____

Abandoned _____

Date

JUL 9 1947 S. J. LEWIS Scout

Map No. 73 Sec. 19 Twp. 15 R. 13W

Well No. 13 Gale Sellens

C R A Company

COMPLETE Contractor

NE NW NW

^{ET 11939}
SECTION PLAT

330 Ft. from N. Line

_____ Ft. from S. Line

_____ Ft. from E. Line

990 Ft. from W. Line

Russell County

o			

Location _____

Rig up _____

Drilling and Remarks:

CR 3296
5" 00296
Pump 107 R

40 2/4

RECORD

Cased _____ in., _____ ft.

Sand _____

Gas _____

Oil _____

Total Depth 8300

PRODUCTION

1st 24 hrs. Nat. _____

1st 24 hrs. after shot _____

Gas _____ Cu. Ft.

Dry Hole _____

Abandoned _____

Date

AUG 6 1947 S. J. LEWIS Scout

KANSAS Russell ✓

Sec. 19 Twp. 15 R. 13-W

Well No. #13 Gale Sellens Farm

C R A Company


Trapp Pool

330 Ft. from N. Line

_____ Ft. from S. Line

_____ Ft. from E. Line

990 Ft. from W. Line

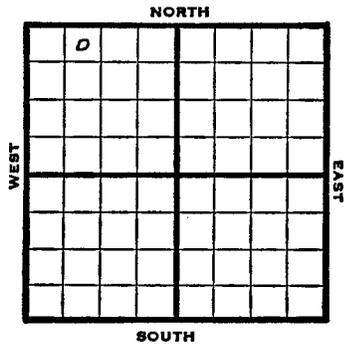

NE NW NW

1947 El. 1859' REPORT

7/9 R U R
7-16 8" @ 868
Drlg. 1932

7/22 "

7/29 Topeka 2737'
Lansing 3039'
Arbuckle 3296'-97' TD
5" @ 3296'

8/6 Arbuckle 3296'
5" @ 3296'
Pump 107 Pot.
Gr. 40.9
T.D. 3300'
Complete

COMPLETED

Russell County

Section 19 Township 15 Range 13-W

Well No. 13 Gale Sellens

Company C R A

Trapp Pool

