

Map No. _____ Sec. 19 Twp. 15 R. 13W

Well No. 14 Gale Sellens

C R A Company

FIRST REPORT Contractor

NE SE NW

SECTION PLAT

		o	

_____ Ft. from N. Line
990 Ft. from S. Line
330 Ft. from E. Line
 _____ Ft. from W. Line

Russell County

Location _____

Rig up _____

Drilling and Remarks:

anhy 832
 8" @ 843
 drlg. 1840

RECORD

Cased _____ in., _____ ft.
 Sand _____
 Gas _____
 Oil _____
 Total Depth _____

PRODUCTION

1st 24 hrs. Nat. _____
 1st 24 hrs. after shot _____
 Gas _____ Cu. Ft.
 Dry Hole _____
 Abandoned _____

Date

JUL 30 1947 19 S. J. LEWIS Scout

Map No. 73 Sec. 19 Twp. 15 R. 13W

Well No. 14 Gale Sellens

C R A Company

COMPLETE Contractor

NE SE NW

SECTION PLAT

		o	

_____ Ft. from N. Line
990 Ft. from S. Line
330 Ft. from E. Line
 _____ Ft. from W. Line

Russell County

Location _____

Rig up _____

Drilling and Remarks:

Re 8282
5' @ 8282
Prod 9/1/47

RECORD

Cased _____ in., _____ ft.
 Sand _____
 Gas _____
 Oil _____
 Total Depth 8284

PRODUCTION

1st 24 hrs. Nat. _____
 1st 24 hrs. after shot _____
 Gas _____ Cu. Ft.
 Dry Hole _____
 Abandoned _____

Date

AUG 20 1947 19 S. J. LEWIS Scout

KANSAS Russell County ✓

Sec. 19 Twp. 15 R. 13-W

Well No. 14 Gale Sellens Farm

C R A Company


Trapp Pool

Ft. from N. Line

990 Ft. from S. Line

330 Ft. from E. Line

Ft. from W. Line

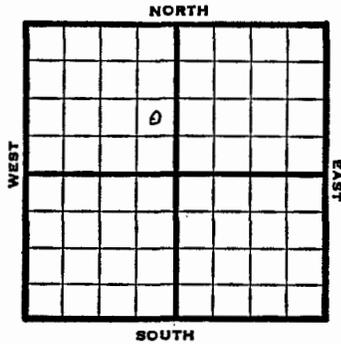

NE SE NW

1947 Elev. 1845' REPORT

7/30 Anhy. 832
8" @ 843
Drlg. 1840

8/6 Lansing 3033'
Arbuckle 3282'
TD 3284'
5" @ 3282'

8/13 RUST
1780 oil, 10 hrs.

8/20 Arb 3282'
5" @ 3282'
Pump 91 Pot.
Gr. 41
TD 3284'
Completed

COMPLETED

KANSAS

Russell

Section 19 Township 15 Range 13W

Well No. 14 Gale Sellens

Company C. R. A.

