


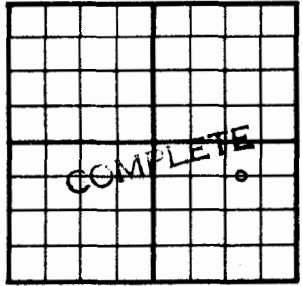

Sec. 19 Twp. 15 R. 13W


County Russell State Kansas  
 Sec. 19 (Blk. Twp.) 15 (Sur. Rge.) 13W Map No.  
 Operator C R A  
 Well No. 10 Farm W. H. Sellens  
 Elev. 1806 Location C W L NE SE

Well No. #10 W.H. Sellens Farm  
 C.R.A. Company  
 Bud Edwards Contractor



660 Ft. From N Line SE  
 990 Ft. From E Line Quarter  
 1st. Report  
 Completion JUL 22 1953  
 Remarks Trapp Pool  
 Bud Edwards - Contr.  
 Spudding Date 5-25-53

660 Ft. from N. Line  
 Ft. from S. Line  
 990 Ft. from E. Line  
 Ft. from W. Line  
 C W L NE-NE SE

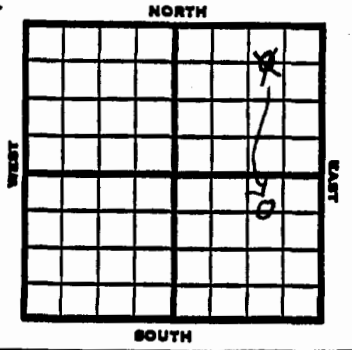

Drlg. Data Oil well TD 3246  
 8" @ 799 Tarkio 2352 2nd Tarkio 2369  
 KC 2979 Arb. 3240 TD 3243 5" @ 3241  
 DD 3246 FU 200' oil 1 hr. P/ 23 bo 5 hr  
 Comp. 30 bopd

1953 Elev. 1806' REPORT

5/27 Spud 5-25-53  
 Drlg 680'  
 6/3 8" @ 799'  
 Drlg.  
 6/24 No report  
 7/22 Spud 5-25-53 Oil well TD 3246  
 8" @ 799 Tarkio 2352 2nd Tarkio  
 2369' KC 2979 Arb. 3240  
 TD 3243 5" @ 3241 DD 3246  
 FU 200' oil 1 hr. P/23 BO 5 hrs.  
 Comp. 30 BOPD

COMPLETED

J. G. McGEHEE

FORM 51

Russell

KANSAS

Section 19 Township 15 Range 13 W

Well No. # 10 W. H. Sellens

Company C R A

