

KANSAS Kansas Pool Name Trapp

Map No. 23 Sec. 19 Twp. 15 R. 13W

Well No. 6 Sellens

Coralena Company

FIRST REPORT Contractor

NE SE

SECTION PLAT

330 Ft. from N. Line

_____ Ft. from S. Line

330 Ft. from E. Line

_____ Ft. from W. Line

			o

Russell County

Location X

Rig up _____

Drilling and Remarks:

RECORD

Cased _____ in., _____ ft.

Sand _____

Gas _____

Oil _____

Total Depth _____

PRODUCTION

1st 24 hrs. Nat. _____

1st 24 hrs. after shot _____

Gas _____ Cu. Ft.

Dry Hole _____

Abandoned _____

Date

MAR 6 1946 19 S. J. LEWIS Scout

KANSAS Kansas Pool Name Trapp

Map No. 23 Sec. 19 Twp. 15 R. 13W

Well No. 6 Sellens

Coralena Company

COMPLETED Contractor

NE SE

SECTION PLAT

330 Ft. from N. Line

_____ Ft. from S. Line

330 Ft. from E. Line

_____ Ft. from W. Line

			o

Russell County

Location _____

Rig up _____

Drilling and Remarks:

Oil 3229

2" @ 3229

Prod 104 Bbl

87° SW

RECORD

Cased _____ in., _____ ft.

Sand _____

Gas _____

Oil _____

Total Depth 3229

PRODUCTION

1st 24 hrs. Nat. _____

1st 24 hrs. after shot _____

Gas _____ Cu. Ft.

Dry Hole _____

Abandoned _____

Date

APR 10 1946 19 S. J. LEWIS Scout

KANSAS Russell County ✓

Sec. 19 Twp. 15 R. 13W

Well No. #6 Sellens Farm

Coralena Company

Trapp


330 Ft. from N. Line

Ft. from S. Line

330 Ft. from E. Line

Ft. from W. Line

NE SE

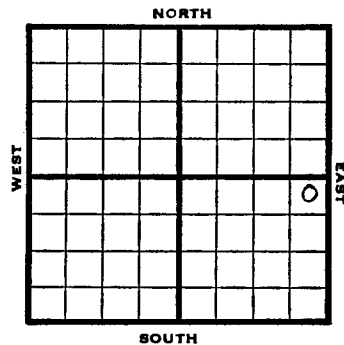


FORM 51 5M PETROL

Section 19 Township 15 Range 13-W

Well No. #6 Sellens

Company Coralena

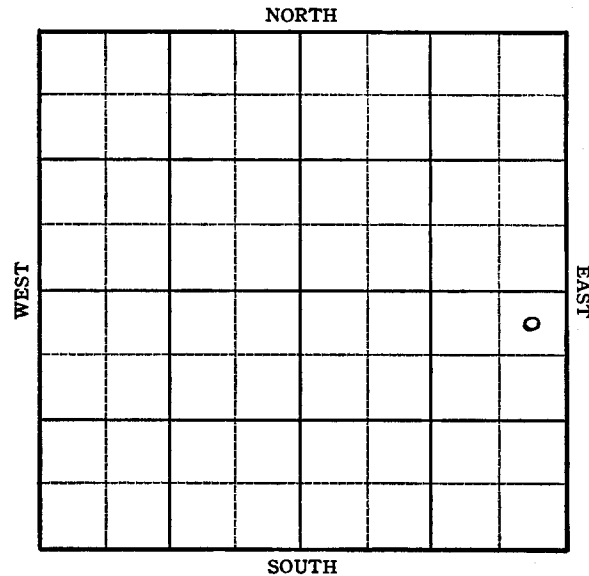

1946 Elev. 1809 REPORT

3/6 Location
 3/14 10" - 460'
 Drlg. 520'
 3/21 Drlg. 2720'
 3/28 Topeka 2696' Lans. 2986'
 Arb. 3229' T.D. 3265'
 7" - 3250' RUST.

4/4 1700' oil in 15 hrs.

4/10 Arb. 3229
 7" @ 3250
 TD 3265'
 Pump 104 Pot.
 Grav. 39.0

COMPLETED