

Map No. _____ Sec. 19 Twp. 15 R. 13W

Well No. 9 W. H. Sellens

C R A _____ Company

C R A _____ Contractor

NE NW SE


FIRST REPORT
SECTION PLAT

330 _____ Ft. from N. Line

_____ Ft. from S. Line

_____ Ft. from E. Line

990 _____ Ft. from W. Line

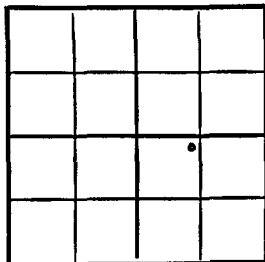

Russell County

Location _____

Rig up _____

Drilling and Remarks:

drlg. 812

RECORD

Cased _____ in., _____ ft.

Sand _____

Gas _____

Oil _____

Total Depth _____

PRODUCTION

1st 24 hrs. Nat. _____

1st 24 hrs. after shot _____

Gas _____ Cu. Ft.

Dry Hole _____

Abandoned _____

Date

JUN 2 2 1949 19 S. J. LEWIS Scout

Map No. K73 Sec. 19 Twp. 15 R. 13W

Well No. 9 W. H. Sellens

C R A _____ Company

COMPLETE

Contractor

NE NW SE


SECTION PLAT

330 _____ Ft. from N. Line

_____ Ft. from S. Line

_____ Ft. from E. Line

990 _____ Ft. from W. Line

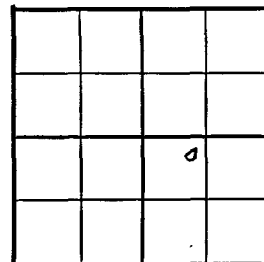

Russell County

Location _____

Rig up _____

Drilling and Remarks:

*Ar 83245**51103250**500acres**Prod 70 oil Bx**40 E. L.*

RECORD

Cased _____ in., _____ ft.

Sand _____

Gas _____

Oil _____

Total Depth *3254*

PRODUCTION

1st 24 hrs. Nat. _____

1st 24 hrs. after shot _____

Gas _____ Cu. Ft.

Dry Hole _____

Abandoned _____

Date

AUG 3 1949 19 S. J. LEWIS Scout

Russell KANSAS ✓
Sec. 19 Twp. 15 R. 13W

Well No. #9 W. H. Sellens Farm
C R A Company

Trapp (C R A, Cont.)


Foot 330' Ft. from N. Line

_____ Ft. from S. Line

_____ Ft. from E. Line

990' Ft. from W. Line

NE NW SE

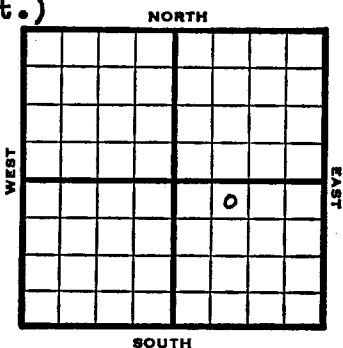

1949 Elev 1878' REPORT

6/22 Drlg. 812'
6/28 8" @ 806'
Drlg 2915'
7/6 Lansing 2991'
Arbuckle 3248'
TD 3254'
5" @ 3250'
7/12 Swb 62 bbls oil 2 hrs.
7;20 "
7/27 500 acid
8/3 TD 3254'
Arb. 3248'
5" @ 3250'
500 acid
Pump 70 oil Pot
40° Gr.
Comp
COMPLETED

KANSAS Russell

Section 19 Township 15 Range 13W

Well No. 9 W.H. Sellens

Company C R A

Trapp NORTH

