

Russell

Map No. 72 Sec. 19 Twp. 15 R. 13W

Well No. 4 Wm. Sellens

Coralena Company

FIRST REPORT Contractor

C SL NW SE


SECTION PLAT

990 Ft. from N. Line

\_\_\_\_\_ Ft. from S. Line

\_\_\_\_\_ Ft. from E. Line

660 Ft. from W. Line

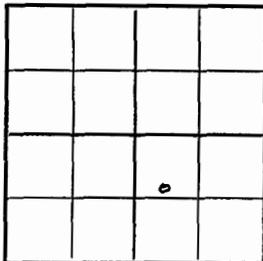

SELLENS POOL

Location \_\_\_\_\_

Rig up \_\_\_\_\_

Drilling and Remarks:

10"-115'

Waiting on  
cement

RECORD

Cased \_\_\_\_\_ in., \_\_\_\_\_ ft.

Sand \_\_\_\_\_

Gas \_\_\_\_\_

Oil \_\_\_\_\_

Total Depth \_\_\_\_\_

PRODUCTION

1st 24 hrs. Nat. \_\_\_\_\_

1st 24 hrs. after shot \_\_\_\_\_

Gas \_\_\_\_\_ Cu. Ft.

Dry Hole \_\_\_\_\_

Abandoned \_\_\_\_\_

Date

MAY 26 1943 19

S. J. LEWIS Scout

Russell

Map No. 72 Sec. 19 Twp. 15 R. 13W

Well No. 4 Wm. Sellens

Coralena Company

COMPLETED Contractor

C SL NW SE


SECTION PLAT

990 Ft. from N. Line

\_\_\_\_\_ Ft. from S. Line

\_\_\_\_\_ Ft. from E. Line

660 Ft. from W. Line

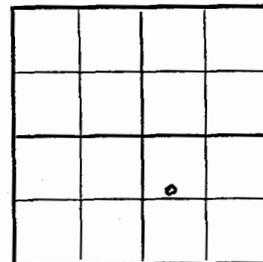

SELLENS POOL

Location \_\_\_\_\_

Rig up \_\_\_\_\_

Drilling and Remarks:

Co # 3276

5" @ 3277

1000 ccio

Pump 598 PD

40°/42

RECORD

Cased \_\_\_\_\_ in., \_\_\_\_\_ ft.

Sand \_\_\_\_\_

Gas \_\_\_\_\_

Oil \_\_\_\_\_

Total Depth 3271

PRODUCTION

1st 24 hrs. Nat. \_\_\_\_\_

1st 24 hrs. after shot \_\_\_\_\_

Gas \_\_\_\_\_ Cu. Ft.

Dry Hole \_\_\_\_\_

Abandoned \_\_\_\_\_

Date

JUN 16 1943 19

S. J. LEWIS Scout

Sec. 19 Twp. 15 R. 13-W

Well No. #4 Wm. Sellens Farm  
Coralena Company

Sellens


990 Ft. from N. Line

\_\_\_\_\_ Ft. from S. Line

\_\_\_\_\_ Ft. from E. Line

660 Ft. from W. Line

Elev. 1832

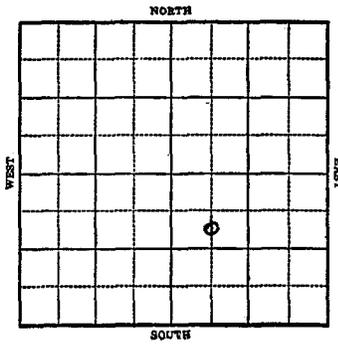

1943

REPORT

5/26 10" @ 115'  
Waiting on Cement

6/2 Drlg. 2500'

6/9 Lans 3016  
Arb 3276 SSO  
T.D. 3290-5" @ 3237 RUST.

6/16 Arb. 3276  
5" @ 3277'  
T.D. 3291'  
1000 gal acid  
Pump 598 Pot  
Gravity 40

**COMPLETED**

Section 19 Township 15 Range 13-W

Well No. #4 Wm. Sellens

Company Coralena

